

NEW LOCATION
 DRILL DEEPER
 ABANDONMENT X

#7319 | 2.3 W 5.49
 #7386 | 5.55 @ 2.7
 2.1 W 5.70 @

FEB 27 1943

COMPANY HOPE NATURAL GAS CO.
 ADDRESS CLARKSBURG, W. VA.
 FARM D. W. CORK 2 TRACTS 44558
 TRACT ACRES 22 & 25 LEASE NO. 7386
 WELL (FARM) NO. _____ SERIAL NO. _____
 ELEVATION (SPIRIT LEVEL) SEE PLAT
 QUADRANGLE CLARKSBURG
 COUNTY HARRISON DISTRICT CLARK
 ENGINEER W. M. BOWER
 ENGINEER'S REGISTRATION NO. 500
 FILE NO. _____ DRAWING NO. _____
 DATE MARCH 16, 1939 SCALE 1" - 300'

SE

STATE OF WEST VIRGINIA
 DEPARTMENT OF MINES
 OIL AND GAS DIVISION
 CHARLESTON
 WELL LOCATION MAP
 FILE NO. HAR 477 4 No 7386

MAP R-945-A; No. 7319
 DENOTES LOCATION OF WELL ON
 UNITED STATES TOPOGRAPHIC MAPS,
 SCALE 1 TO 62,500, LATITUDE AND
 LONGITUDE LINES BEING REPRESENTED
 BY BORDER LINES AS SHOWN.
 DENOTES ONE INCH SPACES ON
 BORDER LINE OF ORIGINAL TRACING



825

STATE OF WEST VIRGINIA
DEPARTMENT OF MINES
OIL AND GAS DIVISION

WELL RECORD

Ab
945-A


Permit No. _____ Oil or Gas Well _____ (KIND)

Company Hope Natural Gas Company.
 Address 445 West Main St. Clarksburg, W. Va.
 Farm D.W. Cook Acres 22.25
 Location (waters) _____
 Well No. 7318 Elev. 982
 District Clark County Harrison
 The surface of tract is owned in fee by _____
 Address _____
 Mineral rights are owned by _____
 Address _____
 Drilling commenced July 3, 1914
 Drilling completed August 9, 1914
 Date Shot _____ From _____ To _____
 With _____
 Open Flow _____ /10ths Water in _____ Inch
 _____ /10ths Merc. in _____ Inch
 Volume _____ Cu. Ft.
 Rock Pressure _____ lbs. _____ hrs.
 Oil _____ bbls., 1st 24 hrs.
 Fresh water none feet _____ feet
 Salt water none feet _____ feet

Casing and Tubing	Used in Drilling	Left in Well	Packers
Size			
16			Kind of Packer
13			
10	875	Pulled	Size of
8 1/4	797	797	
6 5/8	1417	1417	Depth set
5 3/16	1958	1958	
3	3170	3170	Perf. top
2			Perf. bottom
Liners Used			Perf. top
			Perf. bottom

CASING CEMENTED Not SIZE _____ No. Ft. _____ Date _____
 COAL WAS ENCOUNTERED AT None FEET _____ INCHES _____
 FEET _____ INCHES FEET _____ INCHES
 FEET _____ INCHES FEET _____ INCHES

Formation	Color	Hard or Soft	Top	Bottom	Oil, Gas or Water	Depth Found	Remarks
Little Dunkard			210	230			
Big Dunkard			400	440			
First Salt			610	720			
Second Salt			740	800			
Maxon			1010	1040			
Big Lime			1220	1295			
Big Injun			1295	1390			
Gantz			1740	1765			
Fifty foot			1775	1782	gas	1855	
Thirty Foot			1915	1970			
Gordon stray			2042	2060			
Gordon			2069	2114	gas	2075	
Fourth			2115	2129			
Fifth			2194	2225	gas	2204	
Speechley			2897	2906	gas	2898	
Ball Town			3106	3122	gas	3112	
Total depth				3170			

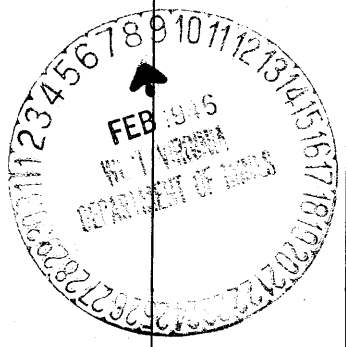

Formation	Color	Hard or Soft	Top	Bottom	Oil, Gas or Water	Depth Found	Remarks

Date February 6, 1946., 194

APPROVED Hope Natural Gas Company., Owner

By *[Signature]* General Superintendent.

