

1
FOR G. W. WOODFIELD, ADDRESS
GARLEN J. ASHCRAFT, WALLACE, HARRISON CO. WVA

2
FOR G. W. WOODFIELD, ADDRESS
W. E. CARSON, WALLACE, HARRISON CO., W. VA.

PITTSBURGH COAL: STATE OF W. VA.

#2
5.33S
0.30W

#1-
5.63S
0.32W

COMPANY ROAD SUPPLY CO,
 ADDRESS SALEM, W. VA.
 FARM G. W. WOODFIELD
 TRACT _____ ACRES 70 LEASE NO. _____
 WELL (FARM) NO. 1 & 2 SERIAL NO. _____
 ELEVATION (SPIRIT LEVEL) 1 1261.40
2 1251.84
 QUADRANGLE _____ CENTERPOINT _____
 COUNTY HARRISON DIST. SARDIS
 ENGINEER E. C. TABLER
 ENGINEER'S REGISTRATION NO. _____
 FILE NO. _____ DWG. NO. _____
 DATE 2/16/46 SCALE 1" - 400'

STATE OF WEST VIRGINIA
 DEPARTMENT OF MINES
 OIL AND GAS DIVISION
 CHARLESTON
 WELL LOCATION MAP
 HAR 954-A; NO. 1
 FILE NO. HAR 955-A; NO. 2

+ DENOTES LOCATION OF WELL ON U. S. TOPOGRAPHIC MAPS, SCALE 1 TO 62,500, LATITUDE AND LONGITUDE LINES BEING REPRESENTED BY BORDER LINES AS SHOWN.
 - DENOTES ONE INCH SPACES ON BORDER LINE OF ORIGINAL TRACING.



797

STATE OF WEST VIRGINIA
DEPARTMENT OF MINES
OIL AND GAS DIVISION

WELL RECORD


Permit No. 955-A Oil or Gas Well X (KIND)

Company Read Supply Company
 Address 184 East Main St., Salem, W. Va.
 Farm G. W. Woodsfield Acres 7 0
 Location (waters) _____
 Well No. 2 Elev. 1251.84
 District Sardia County Harrison
 The surface of tract is owned in fee by W.E. Carson
 Address Wallace, W. Va.
 Mineral rights are owned by STATE OF W. Va.
 Address _____
 Drilling commenced _____
 Drilling completed September 5, 1916
 Date Shot ? From 3109 To 3107
 With _____
 Open Flow /10ths Water in _____ Inch
 /10ths Merc. in _____ Inch
 Volume _____ Cu. Ft.
 Rock Pressure _____ lbs. _____ hrs.
 Oil _____ bbls., 1st 24 hrs.
 Fresh water _____ feet _____ feet
 Salt water _____ feet _____ feet

Casing and Tubing	Used in Drilling	Left in Well	Packers
Size			
16			Kind of Packer
13			
10	309'	None	Size of
8 1/4	1535'	None	
6 5/8	2287'	2287'	Depth set
5 3/16	2891'	2891'	
3			Perf. top
2	3125'	3125'	Perf. bottom
Liners Used			Perf. top
			Perf. bottom

CASING CEMENTED No SIZE _____ No. Ft. _____ Date _____
 COAL WAS ENCOUNTERED AT 1037 FEET 84 INCHES
 FEET INCHES FEET INCHES
 FEET INCHES FEET INCHES

Formation	Color	Hard or Soft	Top	Bottom	Oil, Gas or Water	Depth Found	Remarks
Conductor			16'				
Pittsburgh Coal			1030	1037'			
Big Dunkard Sand			1535	1557			
Little Dunkard Sand			1465	1500			
Big Dunkard Sand			?	?			
Salt Sand			2000	2035			
Salt Sand			2130	2165			
Gas Sand			1635	1700			
Maxon Sand			2175	2200			
Big Lime			2265	2295			
Big Injun Sand			2295	2428			
Fifty Foot Sand			2887	2894			
Thirty Foot Sand			2988	3014			
Stray Sand			3062	3099			
Gordon Sand			3102				
1st Pay			3111				
Total Depth				3125			

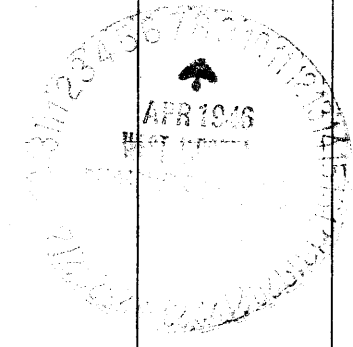

Formation	Color	Hard or Soft	Top	Bottom	Oil, Gas or Water	Depth Found	Remarks

Date February 20, 1946

APPROVED RAAD SUPPLY COMPANY, Owner

By J. M. Raad - Manager, Owner
(Title)

