


JOHN HARBERT

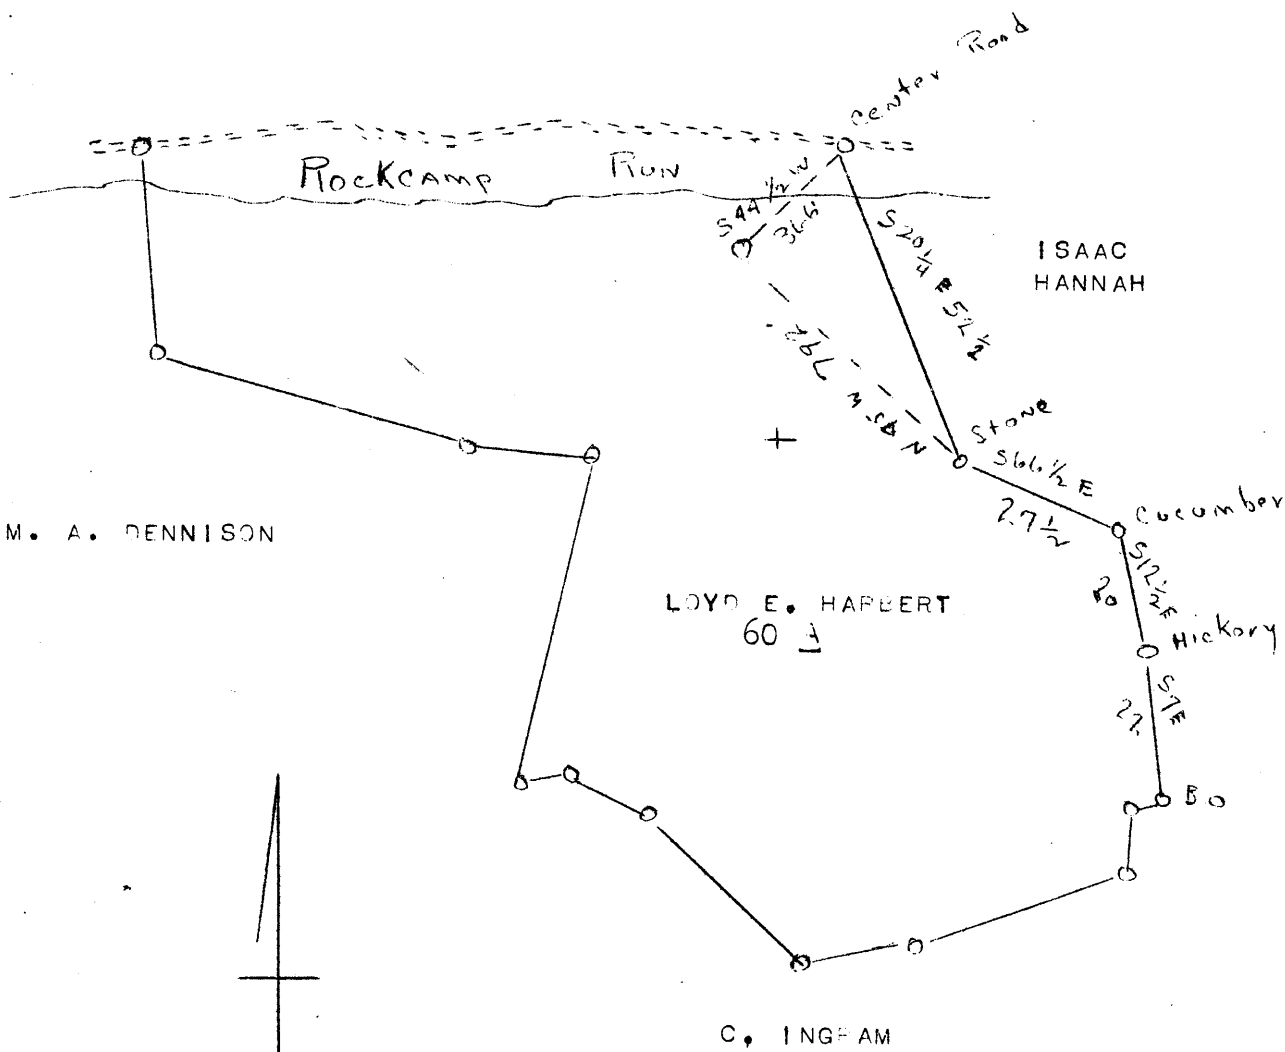

4.74S
3.02W

NEW LOCATION
DRILL DEEPER
ABANDONMENT X

COMPANY WILLIAM MOSES
 ADDRESS 189 W. MAIN ST. SALEM, W. VA.
 FARM LOYD E. HARBERT
 TRACT _____ ACRES 60 LEASE NO. _____
 WELL (FARM) NO. 1 SERIAL NO. _____
 ELEVATION (SPIRIT LEVEL) 1041
 QUADRANGLE CLARKSBURG
 COUNTY HARRISON DISTRICT SALEM
 ENGINEER A. K. WESTFALL
 ENGINEER'S REGISTRATION NO. _____
 FILE NO. _____ DRAWING NO. _____
 DATE 3-11-46 SCALE 1" = 20 POLES

STATE OF WEST VIRGINIA
 DEPARTMENT OF MINES
 OIL & GAS DIVISION
 CHARLESTON

WELL LOCATION MAP

FILE NO. HAR - 962 A

INDICATES LOCATION OF WELL ON UNITED STATES TOPOGRAPHIC MAPS, SCALE 1 TO 62,500, LATITUDE AND LONGITUDE LINES BEING REPRESENTED BY BORDER LINES AS SHOWN.

INDICATES ONE INCH SPACES ON BORDER LINE OF ORIGINAL TRACING.

STATE OF WEST VIRGINIA
DEPARTMENT OF MINES
OIL AND GAS DIVISION

905

WELL RECORD

Permit No. 9624

Oil or Gas Well (Kind)

Company **William Moses**
Address **Salem, W. Va.**
Farm **Lloyd E. Herbert** Acres **60**
Location (waters)
Well No. **One** Elev. **1041**
District **Sardis** County **Harrison**
The surface of tract is owned in fee by **South Penn Nat'l Gas Co.**
Address **Parkersburg, W. Va.**
Mineral rights are owned by
Address
Drilling commenced
Drilling completed
Date shot Depth of shot
Open Flow /10ths Water in Inch
/10ths Merc. in Inch
Volume Cu. Ft.
Rock Pressure lbs. hrs.
Oil bbls., 1st 24 hrs.
Fresh water feet feet
Salt water feet feet

Casing and Tubing	Used in Drilling	Left in Well	Packers
Size			Kind of Packer
16			
13			
8 1/4		188	Size of
6 3/4		965	Depth set
6%		1790	
5 3/16		2459	
3			Perf. top
2		2550	Perf. bottom
Liners Used			Perf. top
			Perf. bottom

CASING CEMENTED SIZE No. Ft. Date
COAL WAS ENCOUNTERED AT **461** FEET INCHES
FEET INCHES FEET INCHES
FEET INCHES FEET INCHES

Formation	Color	Hard or Soft	Top	Bottom	Oil, Gas or Water	Depth Found	Remarks
			461	470			
			840	891			
			965	1015			
			1650	1740			
			1775	1815			
			1815	1902			
			2474	2486			
			2535	2555			
			Total Depth	2566			

MAR 1945
WEST VIRGINIA
DEPARTMENT OF MINES
237557