

New Location   
 Drill Deeper   
 Abandonment

Map Sheet 44 Squares S9E13FB51SP21&23

Company Hope Natural Gas Co.  
 Address Clarksburg, W.Va.  
 Farm V.B. Kyle  
 Tract \_\_\_\_\_ Acres 28 Lease No. 13744  
 Well (Farm) No. \_\_\_\_\_ Serial No. 3236  
 Elevation (Spirit Level) 1125  
 Quadrangle Clarksburg  
 County Harrison District Eagle  
 Engineer W.M. Powers  
 Engineer's Registration No. 900  
 File No. \_\_\_\_\_ Drawing No. \_\_\_\_\_  
 Date 6-3-46 Scale 1" = 400'

STATE OF WEST VIRGINIA  
 DEPARTMENT OF MINES  
 OIL AND GAS DIVISION  
 CHARLESTON

**WELL LOCATION MAP**  
 FILE NO. HAR-981-A

+ Denotes location of well on United States Topographic Maps, scale 1 to 62,500, latitude and longitude lines being represented by border lines as shown.  
 - Denotes one inch spaces on border line of original tracing.



STATE OF WEST VIRGINIA  
DEPARTMENT OF MINES  
OIL AND GAS DIVISION

810

WELL RECORD

Permit No. 981-A


~~Oil~~ or Gas Well \_\_\_\_\_ (KIND)

Company Hope Natural Gas Company.  
 Address 445 West Main St. Clarksburg, W. Va.  
 Farm V.B. Kyle Acres 28  
 Location (waters) \_\_\_\_\_  
 Well No. 3236 Elev. 1125  
 District Eagle County Harrison  
 The surface of tract is owned in fee by \_\_\_\_\_  
 Address \_\_\_\_\_  
 Mineral rights are owned by \_\_\_\_\_  
 Address \_\_\_\_\_  
 Drilling commenced November 3, 1913  
 Drilling completed December 30, 1913  
 Date Shot \_\_\_\_\_ From \_\_\_\_\_ To \_\_\_\_\_  
 With \_\_\_\_\_  
 Open Flow \_\_\_\_\_ /10ths Water in \_\_\_\_\_ Inch  
 \_\_\_\_\_ /10ths Merc. in \_\_\_\_\_ Inch  
 Volume \_\_\_\_\_ Cu. Ft.  
 Rock Pressure \_\_\_\_\_ lbs. \_\_\_\_\_ hrs.  
 Oil \_\_\_\_\_ bbls., 1st 24 hrs.  
 Fresh water 882 feet \_\_\_\_\_ feet  
 Salt water \_\_\_\_\_ feet \_\_\_\_\_ feet

Casing and Tubing	Used in Drilling	Left in Well	Packers
Size			
16			Kind of Packer _____
13			
10	185	185	Size of _____
8 1/4	1065	Pulled	
6 5/8	1479	1479	Depth set _____
5 3/16	2258	2258	
3			Perf. top _____
2			Perf. bottom _____
Liners Used			Perf. top _____
			Perf. bottom _____

CASING CEMENTED 10 SIZE 185 No. Ft. 1913 Date \_\_\_\_\_  
 COAL WAS ENCOUNTERED AT 42 FEET 96 INCHES  
 \_\_\_\_\_ FEET \_\_\_\_\_ INCHES \_\_\_\_\_ FEET \_\_\_\_\_ INCHES  
 \_\_\_\_\_ FEET \_\_\_\_\_ INCHES \_\_\_\_\_ FEET \_\_\_\_\_ INCHES

Formation	Color	Hard or Soft	Top	Bottom	Oil, Gas or Water	Depth Found	Remarks
Pittsburgh Coal			42	50			
Little Dunkard			400	450			
Big Dunkard			510	564			
Gas sand			610	676			
First Salt			694	808			
Second Salt			823	935	water	882	
Little Lime			1345	1360			
Pencil cave			1360	1378			
Big Lime			1378	1451			
Big Injun			1451	1558	gas	1500	
Fifty foot			1982	2021	gas	1990	
Thirty foot			2074	2100			
Gordon Stray			2240	2250	gas	2250	
Gordon			2255	2296	gas	2280	
Fourth			2335	2368			
Fifth			2410	2447	gas	2414 2431	
Speechley			3124	3131	gas	3126	
Total depth				3182			

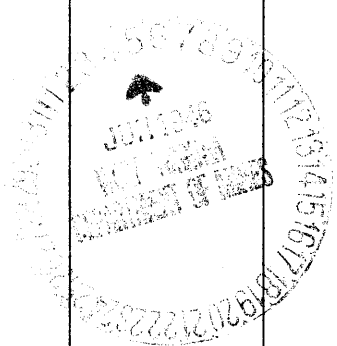

Formation	Color	Hard or Soft	Top	Bottom	Oil, Gas or Water	Depth Found	Remarks

Date June 3, 1946, 194

APPROVED Hope Natural Gas Company., Owner

By J. A. Clark  
J. A. Clark General Superintendent.

