

New Location
 Drill Deeper
 Abandonment X8050

ENOCH POST

MAP 55 SQUARES 516 E 9 FB 780 P 10

Company HOPE NATURAL GAS CO.
 Address CLARKSBURG W.VA.
 Farm PORTER MAXWELL
 Tract _____ Acres 274 Lease No. 52846
 Well (Farm) No. _____ Serial No. SEE ABOVE
 Elevation (Spirit Level) SEE ABOVE
 Quadrangle WESTON
 County HARRISON District UNION
 Engineer Wm Bowen
 Engineer's Registration No. 900
 File No. _____ Drawing No. _____
 Date 7-12-46 Scale 1 IN = 40 POLES

STATE OF WEST VIRGINIA
 DEPARTMENT OF MINES
 OIL AND GAS DIVISION
 CHARLESTON

WELL LOCATION MAP
 FILE NO. HAR 990-A

+ Denotes location of well on United States Topographic Maps, scale 1 to 62,500, latitude and longitude lines being represented by border lines as shown.

- Denotes one inch spaces on border line of original tracing.



STATE OF WEST VIRGINIA
DEPARTMENT OF MINES
OIL AND GAS DIVISION

847

990-A

WELL RECORD

Oil or Gas Well (KIND)

Permit No. 990-A

Company Hope Natural Gas Company.

Address 445 West Main St. Clarksburg, W. Va.

Farm Porter Maxwell Acres 274

Location (waters) _____

Well No. 8050 Elev. 1036

District Union County Harrison

The surface of tract is owned in fee by _____ Address _____

Mineral rights are owned by _____ Address _____

Drilling commenced October 14, 1905

Drilling completed December 14, 1905

Date Shot _____ From _____ To _____

With _____

Open Flow _____ /10ths Water in _____ Inch

_____ /10ths Merc. in _____ Inch

Volume _____ Cu. Ft.

Rock Pressure _____ lbs. _____ hrs.

Oil _____ bbls., 1st 24 hrs.

Fresh water none recorded feet _____ feet

Salt water none recorded feet _____ feet

Casing and Tubing	Used in Drilling	Left in Well	Packers
Size			
16			Kind of Packer
13			
10	163	Pull d	Size of
8 1/4	900	900	
6 3/8	1805	1805	Depth set
5 3/16	2935	2935	
3			Perf. top
2			Perf. bottom
Liners Used			Perf. top
			Perf. bottom

CASING CEMENTED _____ SIZE _____ No. Ft. _____ Date _____


none recorded

COAL WAS ENCOUNTERED AT _____ FEET _____ INCHES

_____ FEET _____ INCHES _____ FEET _____ INCHES

_____ FEET _____ INCHES _____ FEET _____ INCHES

Formation	Color	Hard or Soft	Top	Bottom	Oil, Gas or Water	Depth Found	Remarks
Little Dunkard			375	415			
Big Dunkard			485	580			
Salt sand			600	885			
Little Lime			1260	1284			
Pencil cave			1284	1290			
Big Lime			1290	1355			
Big Injun			1355	1475			
Herea			1680	1710	show oil	1700	
Fifty foot			1800	1825			
Thirty foot			1880	1907			
Gordon stray			2020	2057			
Gordon			2061	2071			
Fifth			2198	2212	gas	2200-2210	
Speechley			2897	2905	gas	2889	
Total depth				2935			

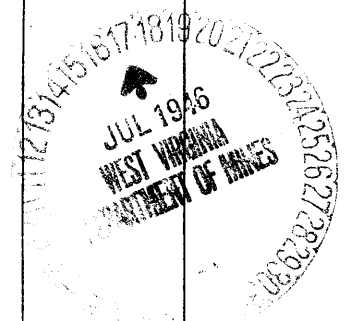

Formation	Color	Hard or Soft	Top	Bottom	Oil, Gas or Water	Depth Found	Remarks

Date July 16, 1946, 194

APPROVED Hope Natural Gas Company., Owner

By [Signature] General Superintendent.