

New Location   
 Drill Deeper   
 Abandonment  8037

Map Sheet 55. Squares S19E10EB.727P2&4

Company Hope Natural Gas Co.  
 Address Clarksburg, W. Va.  
 Farm Wesley Sommerville  
 Tract \_\_\_\_\_ Acres 203 Lease No. 52835  
 Well (Farm) No. \_\_\_\_\_ Serial No. See Above  
 Elevation (Spirit Level) See Above  
 Quadrangle Weston  
 County Harrison District Union  
 Engineer W.M. Bowers  
 Engineer's Registration No. 900  
 File No. \_\_\_\_\_ Drawing No. \_\_\_\_\_  
 Date Aug. 29, 1946 Scale 1" = 660'

STATE OF WEST VIRGINIA  
 DEPARTMENT OF MINES  
 OIL AND GAS DIVISION  
 CHARLESTON

**WELL LOCATION MAP**  
 FILE NO. HAR-1009-A

+ Denotes location of well on United States Topographic Maps, scale 1 to 62,500, latitude and longitude lines being represented by border lines as shown.

- Denotes one inch spaces on border line of original tracing.

H.65  
 O.35W



STATE OF WEST VIRGINIA  
DEPARTMENT OF MINES  
OIL AND GAS DIVISION

852

AD Na/1009-A

WELL RECORD


Oil or Gas Well (KIND)

Company Hope Natural Gas Company.  
 Address 445 West Main St. Clarksburg, W. Va.  
 Farm Wesley Sommerville Acres 203  
 Location (waters) \_\_\_\_\_  
 Well No. 8037 Elev. 972  
 District Union County Harrison  
 The surface of tract is owned in fee by \_\_\_\_\_  
 Address \_\_\_\_\_  
 Mineral rights are owned by \_\_\_\_\_  
 Address \_\_\_\_\_  
 Drilling commenced November 3, 1913  
 Drilling completed December 11, 1913  
 Date Shot \_\_\_\_\_ From \_\_\_\_\_ To \_\_\_\_\_  
 With \_\_\_\_\_  
 Open Flow \_\_\_\_\_ /10ths Water in \_\_\_\_\_ Inch  
 \_\_\_\_\_ /10ths Merc. in \_\_\_\_\_ Inch  
 Volume \_\_\_\_\_ Cu. Ft.  
 Rock Pressure \_\_\_\_\_ lbs. \_\_\_\_\_ hrs.  
 Oil 535 bbls., 1st 24 hrs.  
 Fresh water \_\_\_\_\_ feet \_\_\_\_\_ feet  
 Salt water none feet \_\_\_\_\_ feet

Casing and Tubing	Used in Drilling	Left in Well	Packers
Size			
16			Kind of Packer
13	36	36	
10	150	Pulled	Size of
8 1/4	840	Pulled	
6%	1225	1225	Depth set
5 3/16	✓ 1231	1231	
3			Perf. top
2	2787	2787	Perf. bottom
Liners Used			Perf. top
			Perf. bottom

NOT  
 CASING CEMENTED SIZE No. Ft. Date  
 BELOW  
 COAL WAS ENCOUNTERED AT FEET INCHES  
 FEET INCHES FEET INCHES  
 FEET INCHES FEET INCHES

Formation	Color	Hard or Soft	Top	Bottom	Oil, Gas or Water	Depth Found	Remarks
Little Dunkard			210	260			
Big Dunkard			345	387			
Gas sand			495	565			
First Salt			570	615	water	585	
Second Salt			682	925			
Little Lime			1128	1145			
Pencil cave			1145	1170			
Big Lime			1170	1230			
Big Injum			1230	1345	gas	1240	
Squaw			1460	1480			
Gantz			1665	1687			
Fifty foot			1691	1719			
Thirty foot			1749	1761	gas	1752	
Gordon stray			1882	1925	gas	1920	
Gordon			1923	1971			
Fourth			1976	1992			
Fifth			2070	2036	gas	2075-80	
Speech ley			2762	2772	gas	2766	
Total depth				2787			

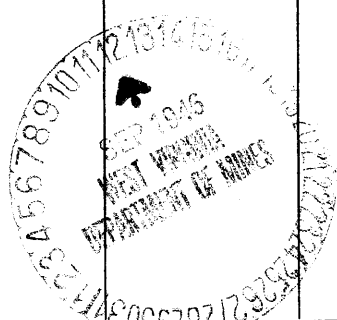

Formation	Color	Hard or Soft	Top	Bottom	Oil, Gas or Water	Depth Found	Remarks

Date **September 10, 1946**, 19

APPROVED **Hope Natural Gas Company.**, Owner

By **General Superintendent.**  
(Title)

