


1
2
3

Longitude 80 15

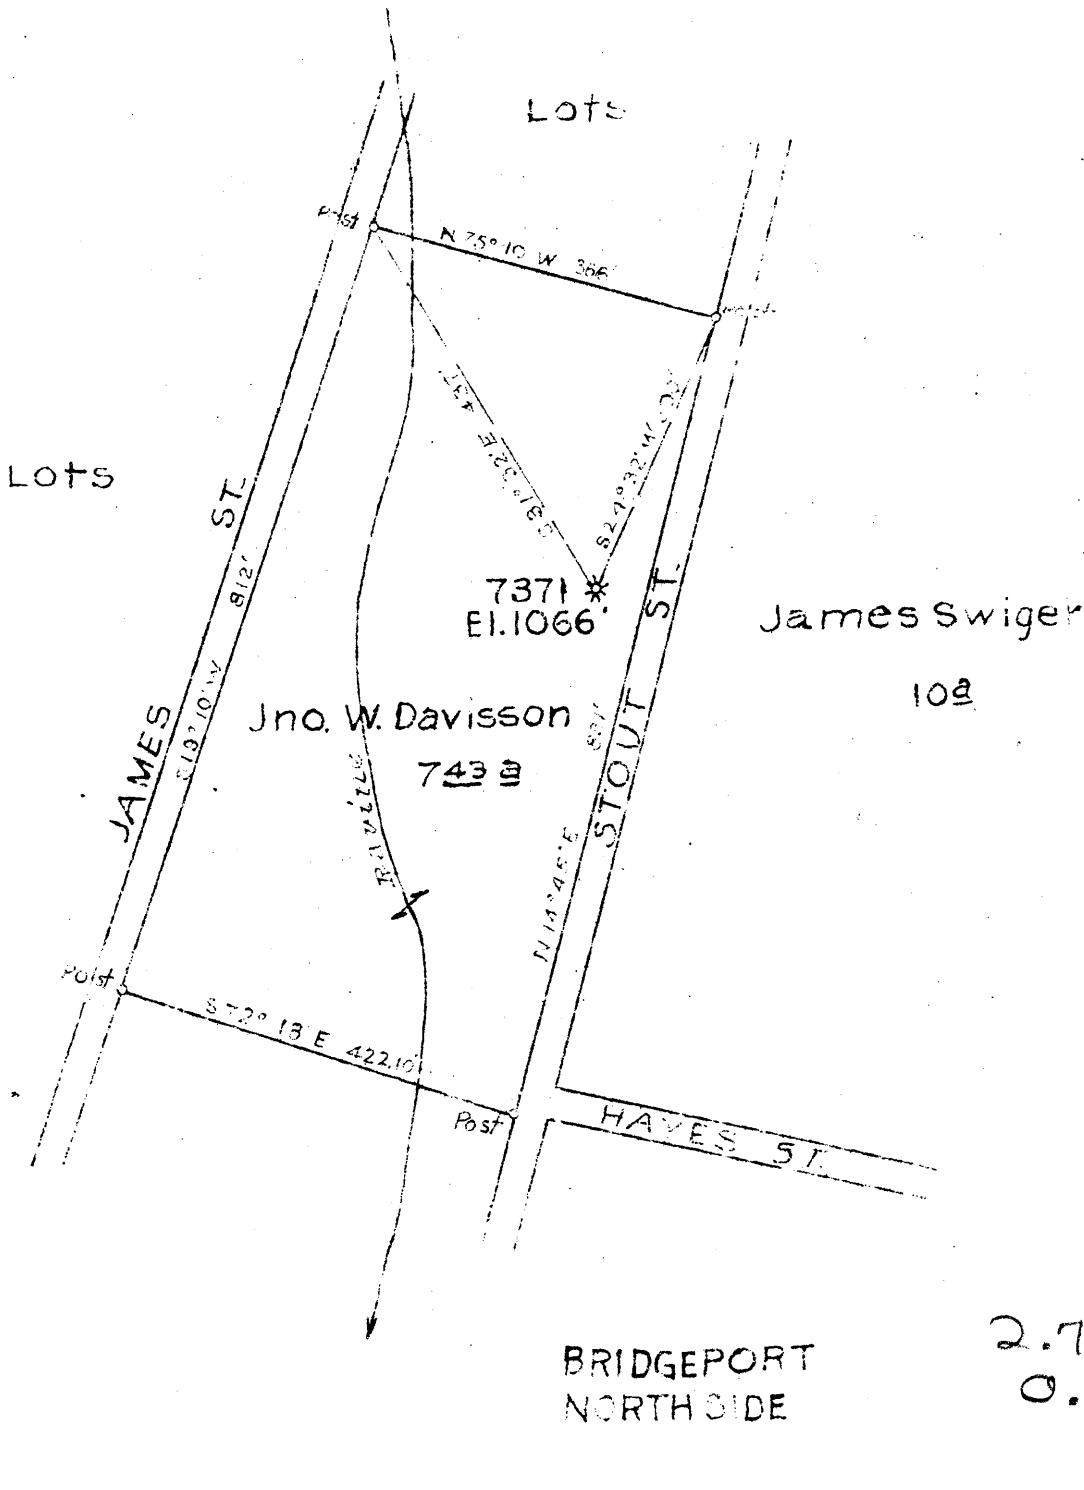

New Location
 Drill Deeper
 Abandonment X

Map Sh. 42 S 12 E 20 EB. 476 Pg. 11.

Company Hope Natural Gas Co
 Address Clarksburg, Wva.
 Farm John W. Davisson
 Tract _____ Acres 743 Lease No. 44611
 Well (Farm) No. _____ Serial No. 7371
 Elevation (Spirit Level) 1066'
 Quadrangle Clarksburg
 County Harrison District Simpson
 Engineer W M Bewers
 Engineer's Registration No. 900
 File No. _____ Drawing No. _____
 Date 9-26-46 Scale 1" = 200'

STATE OF WEST VIRGINIA
 DEPARTMENT OF MINES
 OIL AND GAS DIVISION
 CHARLESTON

WELL LOCATION MAP
 FILE NO. HAR-1014-A

+ Denotes location of well on United States Topographic Maps, scale 1 to 62,500, latitude and longitude lines being represented by border lines as shown

- Denotes one inch spaces on border line of original tracing



STATE OF WEST VIRGINIA
DEPARTMENT OF MINES
OIL AND GAS DIVISION

841

WELL RECORD

Oil or Gas Well _____
(KIND)

Permit No. 1014-A

Company Hope Natural Gas Company.

Address 445 West Main St. Clarksburg, W. Va.

Farm Jno. W. Davisson Acres 7.43

Location (waters) _____

Well No. 7371 Elev. 1066

District Simpson County Harrison

The surface of tract is owned in fee by _____
Address _____

Mineral rights are owned by _____
Address _____

Drilling commenced October 24, 1921

Drilling completed December 5, 1921

Date Shot _____ From _____ To _____

With _____

Open Flow _____ /10ths Water in _____ Inch

_____ /10ths Merc. in _____ Inch

Volume _____ Cu. Ft.

Rock Pressure _____ lbs. _____ hrs.

Oil _____ bbls., 1st 24 hrs.

Fresh water 95 540 feet _____ feet


Salt water _____ feet _____ feet

Casing and Tubing	Used in Drilling	Left in Well	Packers
Size			
16			Kind of Packer _____
13			
10	<u>231</u>	<u>231</u>	Size of _____
8 1/4	<u>872</u>	<u>872</u>	
6	<u>1317</u>	<u>1317</u>	Depth set _____
5 3/16			
3			Perf. top _____
2			Perf. bottom _____
Liners Used			Perf. top _____
			Perf. bottom _____

NOT
CASING CEMENTED _____ SIZE _____ No. Ft. _____ Date _____

none recorded
COAL WAS ENCOUNTERED AT _____ FEET _____ INCHES
_____ FEET _____ INCHES _____ FEET _____ INCHES
_____ FEET _____ INCHES _____ FEET _____ INCHES

Formation	Color	Hard or Soft	Top	Bottom	Oil, Gas or Water	Depth Found	Remarks
					water	95	
	Little Dunkard		165	183			
	Big Dunkard		270	285			
	First Salt		500	595	water	540	
	Second Salt		660	760			
	Big Lime		1245	1315			
	Big Injun		1315	1420	gas	1325	
	Fifty foot		1772	1920			
	Gordon		2118	2127			
	Fifth		2302	2340			
	Filled back to			1859			

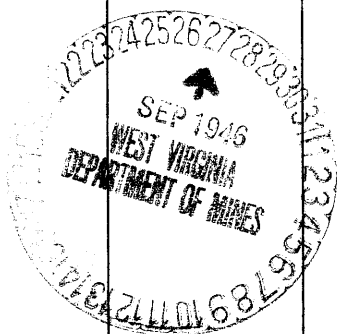

Formation	Color	Hard or Soft	Top	Bottom	Oil, Gas or Water	Depth Found	Remarks

Date September 18, 1946, 19__

APPROVED Hope Natural Gas Company., Owner

By [Signature] General Superintendent.

