

Surface: John Marshok, Reinhart, Harrison Co. W.Va.

Pittsburgh Coal: Formerly Short Line Fuel Co.
 now Willis G. Tetrick Jr. et al. 311 Clay St. Clarksburg, W.Va.

New Location
 Drill Deeper
 Abandonment

Company The Interstate Pipe & Supply Co.
 Address Marietta, Ohio
 Farm A.H. Heldreth
 Tract Acres 121 Lease No. _____
 Wells (Farm No. 5) 3 912 Serial No. _____
 Elevation (Spirit Level) See above at wells
 Quadrangle Clarksburg 4th Center point
 County Harrison District Sardis
 Engineer E.C. Tabler
 Engineer's Registration No. _____
 File No. _____ Drawing No. _____
 Date July 17th 1947 Scale Scale 1" = 400'

STATE OF WEST VIRGINIA
 DEPARTMENT OF MINES
 OIL AND GAS DIVISION
 CHARLESTON

WELL LOCATION MAP

FILE NO. HAR-1128-A-#5
HAR-1130-A-#2
HAR-1133-A-#3

+ Denotes location of well on United States Topographic Maps, scale 1 to 62,500. Latitude and longitude lines being represented by border lines as shown.

- Denotes one inch spaces on border of original tracing.

2.92
 S
 0.17W



700

See Plat 1130

STATE OF WEST VIRGINIA DEPARTMENT OF MINES OIL AND GAS DIVISION

WELL RECORD

Oil or Gas Well 011

(KIND)

Permit No. 1130 A


Company The Interstate Pipe & Supply Company
Address P. O. Box 611, Marietta, Ohio
Farm A. H. Heldreth Acres 121
Location (waters) Big Elk
Well No. 3 Elev. 1375.88
District Sardis County Harrison
The surface of tract is owned in fee by John Marshok
Address Ralhart, W. Va.
Mineral rights are owned by Willis G. Tetrick, Jr., et al
311 Clay Street Address Clarksburg, W. Va.
Drilling commenced June 15, 1903
Drilling completed August 15, 1903
Date Shot '04, '05, '16 From 3034-3285 To
With
Open Flow /10ths Water in Inch
/10ths Merc. in Inch
Volume Cu. Ft.
Rock Pressure lbs. hrs.
Oil bbls., 1st 24 hrs.
Fresh water feet feet
Salt water feet feet

Table with columns: Casing and Tubing, Used in Drilling, Left in Well, Packers. Rows include sizes 16, 13, 10, 8 1/2, 6, 5 3/16, 3, 2 and packer details like '133' 5x5 F.J. on Packer set at 2635'.

CASING CEMENTED SIZE No. Ft. Date
COAL WAS ENCOUNTERED AT 1235 FEET 60 INCHES
FEET INCHES FEET INCHES
FEET INCHES FEET INCHES

Main well log table with columns: Formation, Color, Hard or Soft, Top, Bottom, Oil, Gas or Water, Depth Found, Remarks. Includes entries for Conductor, Coal, Dunkard Sand, Salt Sand, Big Lime, Big Injun, Fifty Foot, Stray Sand, 1st Pay, Gordon Sand, and Total Depth 3342.

Feb. 15, 1917 - Lower Section - 7 jts. - 133' of 5"x5 F.J. Liner hung on cave packer set at 3160'.
Top Section - 7 jts. - 133' of 5X5 F.J. Liner hung on cave packer set at 2635'.

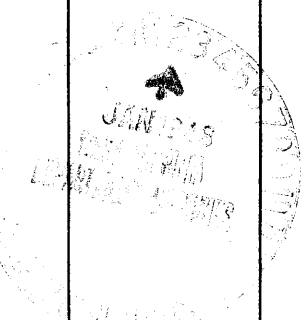

Formation	Color	Hard or Soft	Top	Bottom	Oil, Gas or Water	Depth Found	Remarks

Date December 31, 19 47

APPROVED THE INTERSTATE PIPE & SUPPLY COMPANY, Owner

By Adolph Berens
(Title) 9