

1.52S
3.50W

New Location

Drill Deeper

Abandonment

Company A. M. Snider

Address Hundred W. Va.

Farm Thomas Williams

Tract ONE Acres 8 3/4 Lease No. _____

Well (Farm) No. 1 Serial No. _____

Elevation (Spirit Level) 1192

Quadrangle Centerpoint

County Harrison District Ten Mile

Engineer A. L. Headlee

Engineer's Registration No. 17

File No. _____ Drawing No. _____

Date 2-20-1948 Scale 1 inch = 200 ft

STATE OF WEST VIRGINIA
DEPARTMENT OF MINES
OIL AND GAS DIVISION
CHARLESTON

WELL LOCATION MAP
FILE NO. HAR-1150A

+ Denotes location of well on United States Topographic Maps, scale 1 to 62,500, latitude and longitude lines being represented by border lines as shown.

- Denotes one inch spaces on border line of original tracing



STATE OF WEST VIRGINIA
DEPARTMENT OF MINES
OIL AND GAS DIVISION

903

AD
100-A

WELL RECORD

Oil or Gas Well (KIND)

Permit No. 100-A

Company A. M. Snider

Address Hundred, W, Va.

Farm Thos. Williams Acres 8 3/4

Location (waters) _____

Well No. One Elev. 1112

District Ten Mile County Harrison

The surface of tract is owned in fee by _____
Address _____

Mineral rights are owned by _____
Address _____

Drilling commenced _____

Drilling completed _____

Date Shot _____ From _____ To _____

With _____

Open Flow _____ /10ths Water in _____ Inch
_____ /10ths Merc. in _____ Inch

Volume _____ Cu. Ft.

Rock Pressure _____ lbs. _____ hrs.

Oil _____ bbls., 1st 24 hrs.

Fresh water _____ feet _____ feet


Salt water _____ feet _____ feet

Casing and Tubing	Used in Drilling	Left in Well	Packers
Size			
16			Kind of Packer
13			
10			Size of
8 1/4			
6 1/2	<input checked="" type="checkbox"/>	2240	Depth set
5 3/16		2905	
3			Perf. top
2			Perf. bottom
Liners Used			Perf. top
			Perf. bottom

CASING CEMENTED _____ SIZE _____ No. Ft. _____ Date _____

COAL WAS ENCOUNTERED AT 967 FEET 60 INCHES
_____ FEET _____ INCHES FEET _____ INCHES
_____ FEET _____ INCHES FEET _____ INCHES

Formation	Color	Hard or Soft	Top	Bottom	Oil, Gas or Water	Depth Found	Remarks
Pen. Coal			967	972			
Dunkard Sand.			1550	1610			
Salt Sand.			1800	1880			
Big Lime			2220	2260			
Big Injun.			2260	2325.			
Fifty Foot.			2840	2850			
Stray Sand.			2992	3010			
Gordon Sand			3033	3048.			
Total Depth.				3069.			

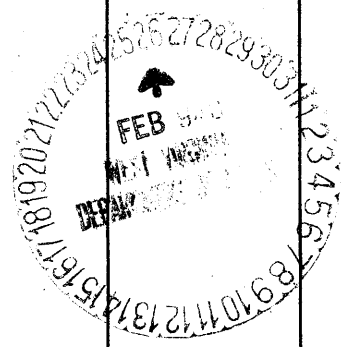

APR 8 1943