



L.B. Maxwell Hrs.
15.8 \bar{a}

Mary E. Williams
5 $\frac{3}{8}$ \bar{a}

8044
El. 1078'

Annie T. Maxwell
3 \bar{a}

Mary A. Davis
6 \bar{a}

Jesse Wilcox
85 $\frac{1}{2}$ \bar{a}

0.58S
0.94W

New Location
Drill Deeper
Abandonment X

Map Sh 55 S 15 E 10 F B. 836 P 36

Company	Hope Natural Gas Co	
Address	Clarksburg, W. Va.	
Farm	Annie T. Maxwell	
Tract	Acres 3	Lease No. 52840
Well (Farm) No.	Serial No. 8044	
Elevation (Spirit Level)	1078'	
Quadrangle	Weston	
County	Harrison	District Union
Engineer	W. M. Bowers	
Engineer's Registration No.	900	
File No.	Drawing No.	
Date 3-5-48	Scale 1" = 10 P	

STATE OF WEST VIRGINIA
DEPARTMENT OF MINES
OIL AND GAS DIVISION
CHARLESTON

WELL LOCATION MAP
FILE NO. HAR-1154-A

+ Denotes location of well on United States Topographic Maps, scale 1 to 62,500. latitude and longitude lines being represented by border lines as shown.

- Denotes one inch spaces on border line of original tracing



STATE OF WEST VIRGINIA
DEPARTMENT OF MINES
OIL AND GAS DIVISION

WELL RECORD

Oil or Gas Well (KIND)

Permit No. 11544


Company Hope Natural Gas Company.
Address 445 West Main St. Clarksburg, W. Va.
Farm Annie T. Maxwell Acres 3
Location (waters) _____
Well No. 8044 Elev. 1078
District Union County Harrison
The surface of tract is owned in fee by _____
Address _____
Mineral rights are owned by _____
Address _____
Drilling commenced January 30, 1911
Drilling completed February 25, 1911
Date Shot _____ From _____ To _____
With _____

Casing and Tubing	Used in Drilling	Left in Well	Packers
Size			Kind of Packer
16			
13			
10	190	Pulled	Size of
8 1/4	924	Pulled	
6 5/8	1354	1354	Depth set
5 3/16	1939	1939	
3			Perf. top
2			Perf. bottom
Liners Used			Perf. top
			Perf. bottom

Open Flow _____ /10ths Water in _____ Inch
_____ /10ths Merc. in _____ Inch
Volume _____ Cu. Ft.
Rock Pressure _____ lbs. _____ hrs.
Oil _____ bbls., 1st 24 hrs.
Fresh water none recorded feet _____ feet
Salt water none recorded feet _____ feet

NOT
CASING CEMENTED _____ SIZE _____ No. Ft. _____ Date _____
BELOW
COAL WAS ENCOUNTERED AT _____ FEET _____ INCHES
_____ FEET _____ INCHES _____ FEET _____ INCHES
_____ FEET _____ INCHES _____ FEET _____ INCHES

Formation	Color	Hard or Soft	Top	Bottom	Oil, Gas or Water	Depth Found	Remarks
Little Dunkard			355	395			
Gas sand			540	580			
First Salt			615	750			
Maxon			1120	1155			
Little Lime			1222	1240			
Pencil cave			1240	1260			
Big Lime			1260	1340			
Big Injun			1340	1431			
Squaw			1450	1545			
Gantz			1660	1682			
Fifty foot			1754	1840	show gas	1760	
Thirty foot			1865	1895	gas	1875	
Gordon stray			2000	2023			
Gordon			2030	2045			
Fourth			2124	2139			
Fifth			2188	2204	gas	2191	
Bayard			2322	2353			
Speechley			2890	2899	gas	2892	
Total depth				2916			

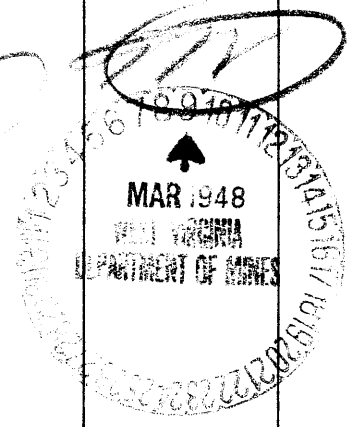

Bailer lost in hole about 2180 account caving were unable to recover in 1943
Have been unable to get below 2010'

JUN 16 1948

Formation	Color	Hard or Soft	Top	Bottom	Oil, Gas or Water	Depth Found	Remarks

Date **March 3, 1948.**, 19____

APPROVED **Hope Natural Gas Company.**, Owner

By _____ (Title)