

New Location
 Drill Deeper
 Abandonment On 400' map # 3153

Company Beren and Strauss.
 Address Marietta, Ohio.
 Farm G.W. Talkington
 Tract _____ Acres 115 Lease No. _____
 Well (Farm) No. 1 Serial No. _____
 Elevation (Spirit Level) Floor - 1329.20
Ground - 1327.20
 Quadrangle CLARKSBURG
 County Harrison District Sardis
 Engineer E.C. Tabler
 Engineer's Registration No. _____
 File No. _____ Drawing No. _____
 Date March 22nd 1948 Scale 1" = 400 Feet.

STATE OF WEST VIRGINIA
 DEPARTMENT OF MINES
 OIL AND GAS DIVISION
 CHARLESTON

WELL LOCATION MAP
 FILE NO. HAR-1167-A
 was! HAR-7019S

+ Denotes location of well on United States Topographic Maps, scale 1 to 62,500, latitude and longitude lines being represented by border lines as shown.

- Denotes one inch spaces on border line of original tracing.



STATE OF WEST VIRGINIA
DEPARTMENT OF MINES
OIL AND GAS DIVISION

1034

WELL RECORD

Permit No. 1077A Oil or Gas Well 011
(KIND)


Company <u>Boren & Straus</u>	Casing and Tubing	Used in Drilling	Left in Well	Packers
Address <u>Marietta, Ohio</u>	Size			
Farm <u>G. W. Talkington</u> Acres <u>363</u>	16			Kind of Packer
Location (waters) <u>Middle Run</u>	13			
Well No. <u>1</u> Elev. <u>1329.20</u>	10	<u>340</u>	<u>none</u>	Size of
District <u>Sardis</u> County <u>Harrison</u>	8 1/4	<u>1540</u>	<u>"</u>	
The surface of tract is owned in fee by <u>Bessie Stiers Hrs.</u>	6%	<u>2293</u>	<u>2293</u>	Depth set
<u>Vada Haldreth</u> Address <u>Lumberport, W.Va.</u>	5 3/16	<u>2480</u>	<u>2480</u>	
Mineral rights are owned by <u>So. Penn. Nat'l Gas Co.</u>	3			Perf. top
Address <u>Smithfield, W.Va.</u>	2			Perf. bottom
Drilling commenced	Liners Used			Perf. top
Drilling completed <u>April 16, 1901</u>				Perf. bottom
Date Shot From To				
With				

Open Flow /10ths Water in _____ Inch
 _____ /10ths Merc. in _____ Inch
 Volume _____ Cu. Ft.
 Rock Pressure _____ lbs. _____ hrs.
 Oil _____ bbls., 1st 24 hrs.
 Fresh water _____ feet _____ feet
 Salt water _____ feet _____ feet

CASING CEMENTED _____ SIZE _____ No. Ft. _____ Date _____

COAL WAS ENCOUNTERED AT 1060 FEET _____ INCHES
 _____ FEET _____ INCHES FEET _____ INCHES
 _____ FEET _____ INCHES FEET _____ INCHES

Formation	Color	Hard or Soft	Top	Bottom	Oil, Gas or Water	Depth Found	Remarks
Pitts. Coal			1060	1065			
Big Line			2286	2334			
Big Injun			2334	2474			
Stray Sand			3100	3125			
Gordon Sand			3139	3167			
1st Pay			3151				
2nd Pay			3178				
Total Depth				3221'			

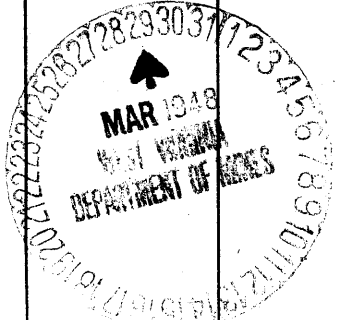

NOW HAR-1167A 70/95

...S.A.P.O.O. District, Harrison County, W. Va.
By South Penn Oil Co.

See plat 633 1843

	Top.	Bottom.
Dunkard Sand	1440	- 1465
Dunkard Sand	1525	- 1600
Gas Sand	1779	- 1839
Salt Sand	1975	- 2025
Big Lime	2286	- 2334
Big Injun Sand	2334	- 2474
Gantz Sand	2790	- 2820
50-Ft. Sand	2914	- 2954
Boulder Sand	3020	- 3050
Stray Sand	3100	- 3125
Gordon Sand (pay, 3151')	3139	- 3167
Slate	3167	- 3178
Sand (pay, 3178')	3178	- 3186
Slate, to bottom	3186	- 3221