

1.76S  
2.43W

New Location   
 Deeper   
 Government

Property A.M. Snider  
 Address Hundred, W. Va.  
 Farm C.W. Smith  
 Tract CNE Acres 60.64 Lease No. \_\_\_\_\_  
 Well (Farm) No. 2 Serial No. \_\_\_\_\_  
 Elevation (Spirit Level) 1120'  
 Quadrangle Clarksburg  
 County Harrison District Tennie  
 Engineer A.L. Headley  
 Engineer's Registration No. \_\_\_\_\_  
 File No. \_\_\_\_\_ Drawing No. \_\_\_\_\_  
 Date 3-30-1948 Scale 1 inch = 500 ft

STATE OF WEST VIRGINIA  
 DEPARTMENT OF MINES  
 OIL AND GAS DIVISION  
 CHARLESTON

WELL LOCATION MAP  
 FILE NO. HAR-1212-A

+ Denotes location of well on United States Topographic Maps, scale 1 to 62,500, latitude and longitude lines being represented by border lines as shown.

- Denotes one inch spaces on border line of original tracing.



STATE OF WEST VIRGINIA  
DEPARTMENT OF MINES  
OIL AND GAS DIVISION

907

WELL RECORD

Permit No. KAR-1212-A


Oil or Gas Well Oil (KIND)

Company G. M. ...  
 Address Harrison, W. Va.  
 Farm E. W. Smith Acres \_\_\_\_\_  
 Location (waters) \_\_\_\_\_  
 Well No. 2 Elev. \_\_\_\_\_  
 District Harrison County Harrison  
 The surface of tract is owned in fee by \_\_\_\_\_  
 Address \_\_\_\_\_  
 Mineral rights are owned by \_\_\_\_\_  
 Address \_\_\_\_\_  
 Drilling commenced \_\_\_\_\_  
 Drilling completed 1-27-1899  
 Date Shot \_\_\_\_\_ From \_\_\_\_\_ To \_\_\_\_\_  
 With \_\_\_\_\_  
 Open Flow \_\_\_\_\_ /10ths Water in \_\_\_\_\_ Inch  
 \_\_\_\_\_ /10ths Merc. in \_\_\_\_\_ Inch  
 Volume \_\_\_\_\_ Cu. Ft.  
 Rock Pressure \_\_\_\_\_ lbs. \_\_\_\_\_ hrs.  
 Oil \_\_\_\_\_ bbls., 1st 24 hrs.  
 Fresh water \_\_\_\_\_ feet \_\_\_\_\_ feet  
 Salt water \_\_\_\_\_ feet \_\_\_\_\_ feet

Casing and Tubing	Used in Drilling	Left in Well	Packers
Size			
16			Kind of Packer
13			
10			Size of
8 1/4		<u>800</u>	
6 1/2		<u>1664</u>	Depth set
5 3/16			
3			Perf. top
2			Perf. bottom
Liners Used			Perf. top
			Perf. bottom

CASING CEMENTED \_\_\_\_\_ SIZE \_\_\_\_\_ No. Ft. \_\_\_\_\_ Date \_\_\_\_\_  
 COAL WAS ENCOUNTERED AT 275 FEET 72 INCHES  
 \_\_\_\_\_ FEET \_\_\_\_\_ INCHES FEET \_\_\_\_\_ INCHES  
 \_\_\_\_\_ FEET \_\_\_\_\_ INCHES FEET \_\_\_\_\_ INCHES

Formation	Color	Hard or Soft	Top	Bottom	Oil, Gas or Water	Depth Found	Remarks
<u>Pepl. Coal</u>			<u>275</u>	<u>281</u>			
<u>Dunkard</u>			<u>800</u>	<u>900</u>			
<u>Big limestone</u>			<u>1675</u>	<u>1750</u>			
<u>" layers</u>			<u>1755</u>	<u>1850</u>			
<u>50 ft</u>			<u>2215</u>	<u>2255</u>			
<u>Redden</u>			<u>2315</u>	<u>2480</u>			
<u>5th</u>			<u>2653</u>	<u>2664</u>			
<u>Intal</u>				<u>2686</u>			

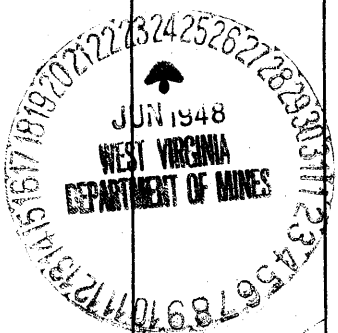

JUL 23 1948

C. W. SMITH NO. 2 WELL.

Tennile District, Harrison County, W. Va.

By A. M. Snider, Hundred, W. Va.

Abandoned under permit Har-.....Af

On.....acres.

Elevation.....

Drilling completed Jan. 27, 1899.

8 $\frac{1}{2}$ " casing, 800'; 6 $\frac{5}{8}$ "", 1664'; all left in.

Coal was encountered at 275-281'.

Gas well. Record to Dept. of Mines stamped June 24, 1948.

Record to RCT from Mrs. Griffith July 23, 1948. Old File No. 987.

	Top.	Bottom.
Pittsburgh Coal	275	- 280
Dunkard Sand	800	- 900
Big Lime	1675	- 1750
Big Injun Sand	1755	- 1855
50-Ft. Sand	2215	- 2255
Gordon Sand	2315	- 2480
5th Sand	2653	- 2664
Total depth		2686

1212A