


Latitude 39° 25'

Longitude 90° 30'

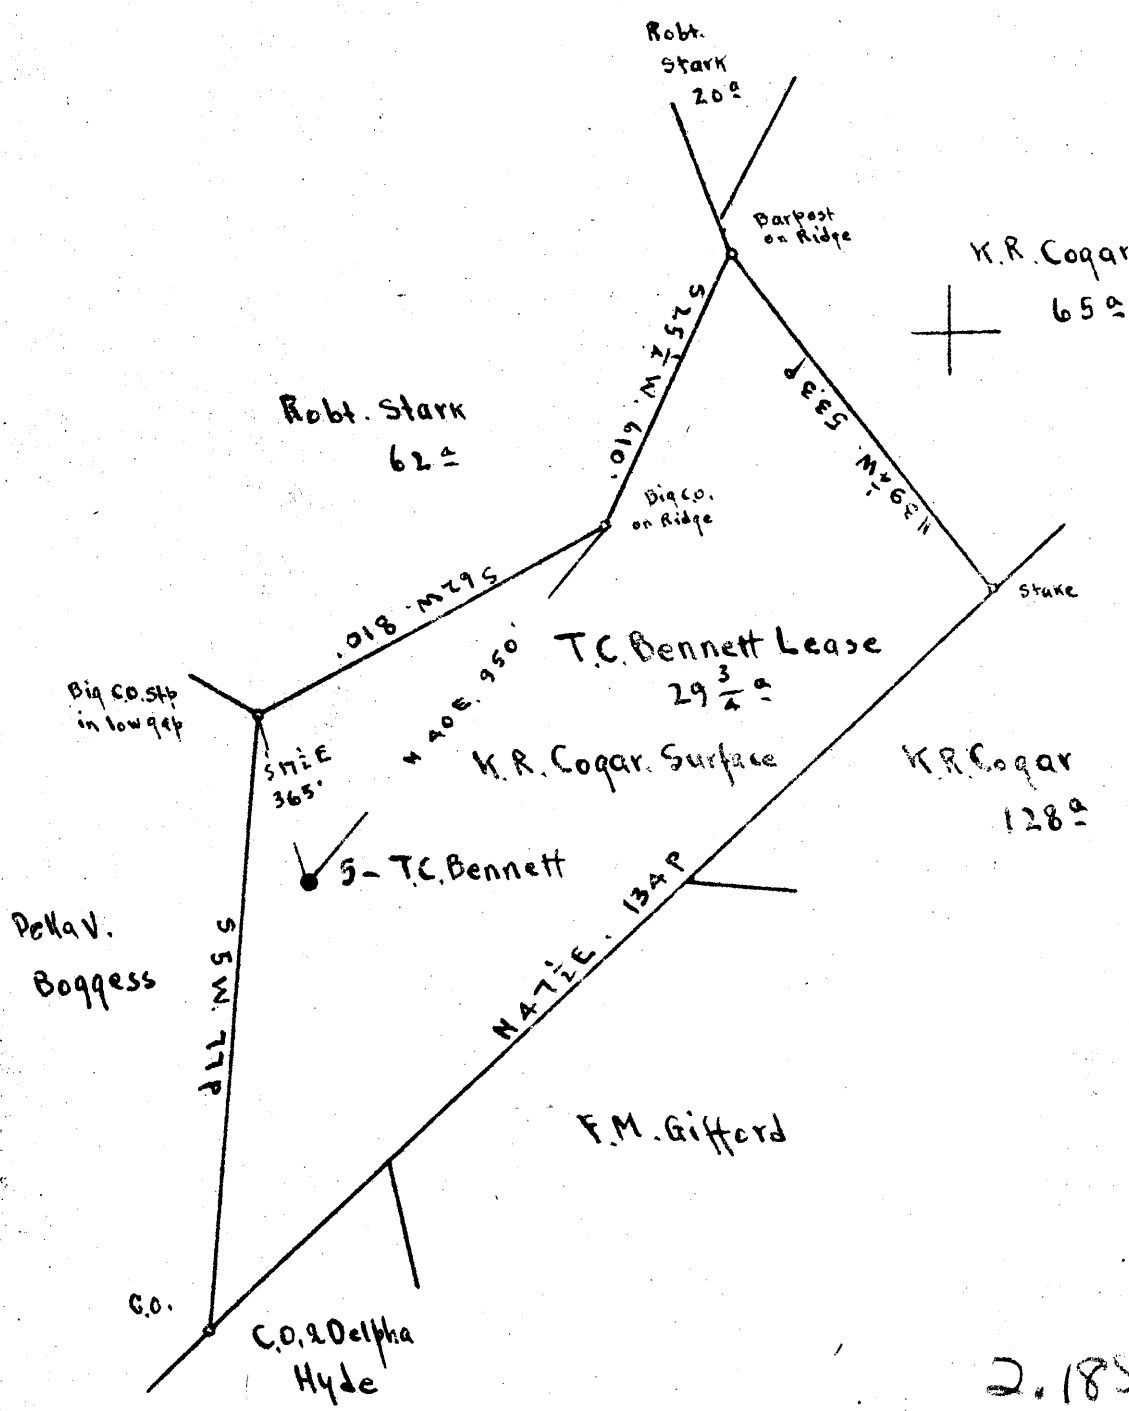

2.185
2.02W

Surface: K.R. Coqar, R.F.D #1, Wallace, Harrison Co., W.Va.
 Coal: Miss Margaret Anne Tetrick, 271 Clay St., Clarksburg, W.Va.

New Location
 Drill Deeper
 Abandonment

On 400' map # 3252

S 5 E S

Company Strauss and Beren
 Address Marietta Ohio
 Farm T.C. Bennett
 Tract Acres 29 3/4 Lease No. _____
 Well (Farm) No. 5 Serial No. _____
 Elevation (Spirit Level) Floor = 1427.28
Ground = 1427.28
 Quadrangle CENTERPOINT
 County Harrison District Sardis
 Engineer E.C. Tabler
 Engineer's Registration No. _____
 File No. _____ Drawing No. _____
 Date June 4th 1948 Scale 1" = 400 Feet

STATE OF WEST VIRGINIA
 DEPARTMENT OF MINES
 OIL AND GAS DIVISION
 CHARLESTON

WELL LOCATION MAP
 FILE NO. HAR-1216-A

+ Denotes location of well on United States Topographic Maps, scale 1 to 62,500, latitude and longitude lines being represented by border lines as shown.

- Denotes one inch spaces on border line of original tracing.



STATE OF WEST VIRGINIA
DEPARTMENT OF MINES
OIL AND GAS DIVISION

991

WELL RECORD

Permit No. 1716-A Oil or Gas Well X (KIND)

Company Strauss & Beren
 Address Marietta, Ohio
 Farm T. C. Bennett Acres 29 3/4
 Location (waters) Lost Run
 Well No. 5 Elev 1427.28
 District Sardis County Harrison
 The surface of tract is owned in fee by K. R. Cogar
 Address RFD # 1, Wallace,
 Mineral rights are owned by Miss Margaret Anne
Tetrick Address 271 Cloy Street,
Clarksburg, W. Va.
 Drilling commenced _____
 Drilling completed _____
 Date Shot _____ From _____ To _____
 With _____

Casing and Tubing	Used in Drilling	Left in Well	Packers
Size			
16			Kind of Packer
18			
10	305	none	Size of
8 1/4	1655	1167	
6 1/2	2492	2492	Depth set
5 3/16	3102	3102	
3			Perf. top
2			Perf. bottom
Liners Used			Perf. top
			Perf. bottom

Open Flow _____ /10ths Water in _____ Inch
 _____ /10ths Merc. in _____ Inch
 Volume _____ Cu. Ft.
 Rock Pressure _____ lbs. _____ hrs.
 Oil _____ bbls., 1st 24 hrs.
 Fresh water _____ feet _____ feet
 Salt water _____ feet _____ feet

CASING CEMENTED _____ SIZE _____ No. Ft. _____ Date _____

COAL WAS ENCOUNTERED AT **1186** FEET _____ INCHES
 _____ FEET _____ INCHES FEET _____ INCHES
 _____ FEET _____ INCHES FEET _____ INCHES

Formation	Color	Hard or Soft	Top	Bottom	Oil, Gas or Water	Depth Found	Remarks
Pgh Coal			1186	1191			
Dunkard Sand			1630	1675			
Salt Sand			1965	1995			
2nd Salt Sand			2130	2155			
Maxon Sand			2285	2320			
Little Lime			2415	2444			
Big Lime			2455	2505			
Big Injun			2505	2620			
50ft. Sand			3060	3095			
30ft. Sand			3175	3197			
Stray Sand			3225	3273			
Gordon Sand			3288	3310			
TOTAL DEPTH				3347			

