

Surface - Samuel & Rosie Gianettino

New Location
 Drill Deeper
 Abandonment

Company A. M. Snider
 Address Hundred, W. Va.
 Farm D. T. Martin
 Tract 1 Acres 89 Lease No. _____
 Well (Farm) No. 2 & 3 Serial No. _____
 Elevation (Spirit Level) # 2 = 1375'
3 = 1155'
 Quadrangle Clarksburg
 County Harrison District Tennile
 Engineer A. L. Headley
 Engineer's Registration No. _____
 File No. _____ Drawing No. _____
 Date 7-28-1948 Scale 1" = 500'

STATE OF WEST VIRGINIA
 DEPARTMENT OF MINES
 OIL AND GAS DIVISION
 CHARLESTON

WELL LOCATION MAP

FILE NO. HAR-1229-A-#2
HAR-1230-A-#3

+ Denotes location of well on United States Topographic Maps, scale 1 to 62,500, latitude and longitude lines being represented by border lines as shown.

- Denotes one inch spaces on border line of original tracing.



1002

STATE OF WEST VIRGINIA
DEPARTMENT OF MINES
OIL AND GAS DIVISION

WELL RECORD

Oil or Gas Well _____
(KIND)

Permit No. 1002-A

Company G. M. Bruden

Address Hammond, W. Va

Farm S. J. Martin Acres _____

Location (waters) _____

Well No. 2 Elev. _____

District Snyder County Harman

The surface of tract is owned in fee by _____
Address _____

Mineral rights are owned by _____
Address _____

Drilling commenced _____

Drilling completed 12/13/1900

Date Shot _____ From _____ To _____

With _____

Open Flow _____ /10ths Water in _____ Inch
_____ /10ths Merc. in _____ Inch

Volume _____ Cu. Ft.

Rock Pressure _____ lbs. _____ hrs.

Oil _____ bbls., 1st 24 hrs.

Fresh water _____ feet _____ feet

Salt water _____ feet _____ feet

Casing and Tubing	Used in Drilling	Left in Well	Packers
Size			
16			Kind of Packer
13			
10		55	<u>Hard Vegetable</u>
8 1/4		962	
6%		1982	Depth set
5 3/16			
3			Perf. top
2			Perf. bottom
Liners Used			Perf. top
			Perf. bottom


CASING CEMENTED _____ SIZE _____ No. Ft. _____ Date _____

COAL WAS ENCOUNTERED AT 535 FEET 96 INCHES

_____ FEET _____ INCHES _____ FEET _____ INCHES

_____ FEET _____ INCHES _____ FEET _____ INCHES

Formation	Color	Hard or Soft	Top	Bottom	Oil, Gas or Water	Depth Found	Remarks
<u>Pgh Coal</u>			<u>535</u>	<u>543</u>			
<u>Beahard</u>			<u>1045</u>	<u>1080</u>			
<u>Begheim</u>			<u>1890</u>	<u>1984</u>			
<u>" Bryan</u>			<u>1984</u>	<u>2060</u>			
<u>50 ft</u>			<u>2495</u>	<u>2530</u>			
<u>Stray</u>			<u>2575</u>	<u>2606</u>			
<u>Gordon</u>			<u>2610</u>	<u>2730</u>			
<u>5th</u>			<u>2909</u>	<u>2916</u>			
<u>Total Depth</u>				<u>2929</u>			

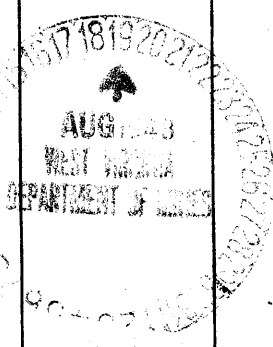

D. T. MARTIN NO. 2 WELL.

1229A

Sardis District, Harrison County, W. Va.

By A. M. Snider, Hundred, W. Va.

Abandoned under permit Har-.....-A?

On.....acres.

Elevation,.....' L.

Drilling completed Dec. 13, 1900.

10" casing, 55'; 8 $\frac{1}{4}$ ", 962'; 6 $\frac{5}{8}$ ", 1982'.

Coal was encountered at 535-543'.

Oil? well. Record to Dept. of Mines stamped Aug. 19, 1948.

Record to RCT from Mrs. Griffith Sept. 3, 1948. Old File No. 1002.

	Top.	Bottom.
Pittsburgh Coal	535	- 543
Dunkard Sand	1045	- 1080
Big Lime	1890	- 1984
Big Injun Sand	1984	- 2060
50-Ft. Sand	2495	- 2530
Stray Sand	2575	- 2606
Gordon Sand	2610	- 2730
5th Sand	2909	- 2916
Total depth		2929