


Scale. 1" = 400 Feet

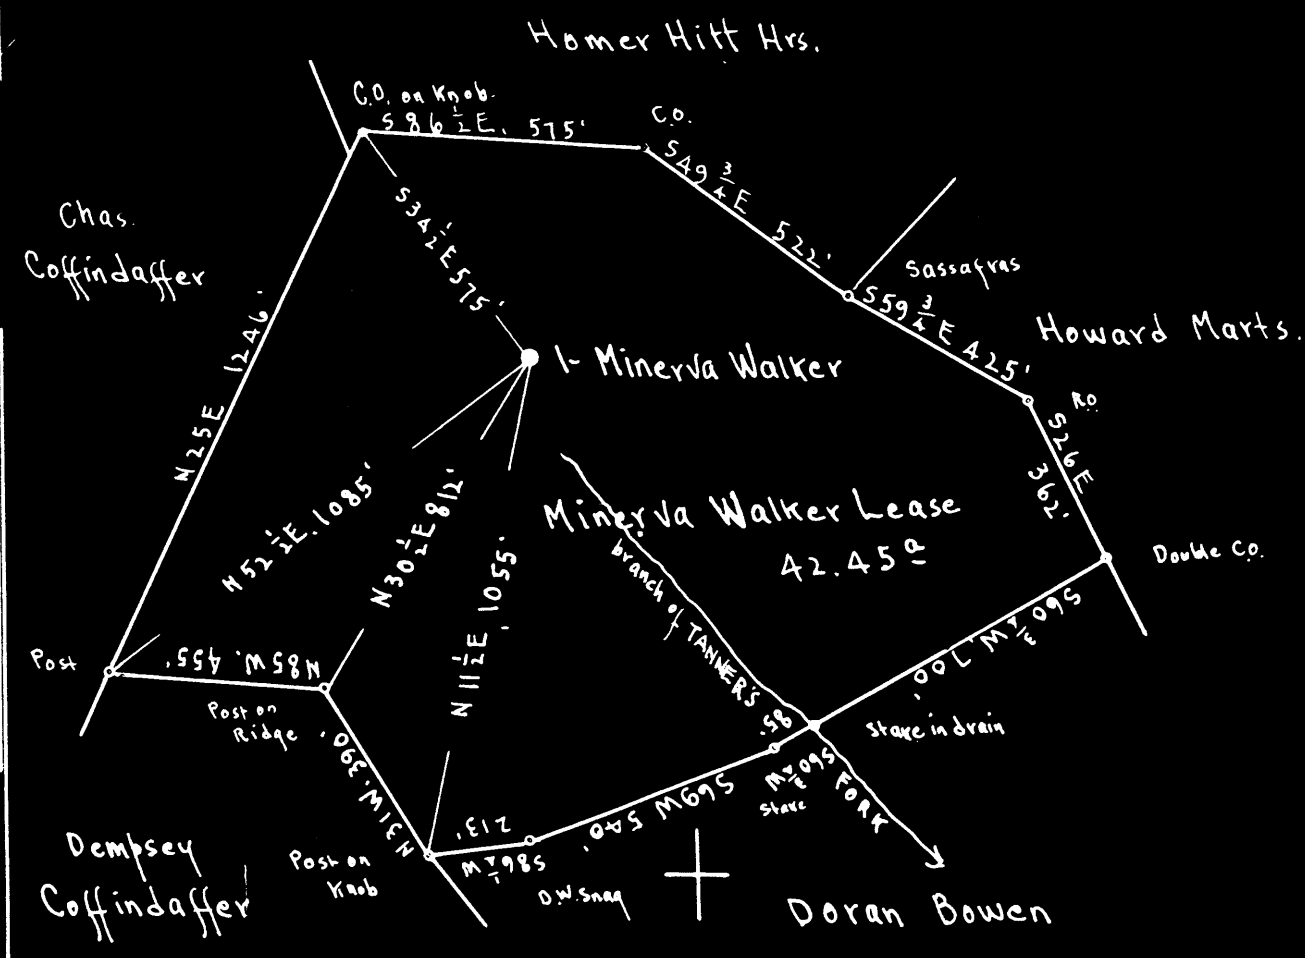

Surface: Gainer Wise, Salem, W. Va.
 Coal: State of West Virginia.

New Location
 Drill Deeper
 Abandonment On 400' map # 4051 S 20 E 2-3

Company Bradford Supply Co.
 Address Mattoon, Illinois
 Farm Minerva Walker
 Tract Acres 42.45 Lease No. _____
 Well (Farm) No. 1 Serial No. _____
 Elevation (Spirit Level) Floor 1250.00
Ground - 1248.00
 Quadrangle VAD15
 County Harrison District Union
 Engineer E.C. Tabler
 Engineer's Registration No. _____
 File No. _____ Drawing No. _____
 Date May 26th 1948 Scale 1" = 400 Feet.

STATE OF WEST VIRGINIA
 DEPARTMENT OF MINES
 OIL AND GAS DIVISION
 CHARLESTON

WELL LOCATION MAP
 FILE NO. HAR-1235-A

+ Denotes location of well on United States Topographic Maps, scale 1 to 62,500, latitude and longitude lines being represented by border lines as shown.
 - Denotes one inch spaces on border line of original tracing.



STATE OF WEST VIRGINIA
DEPARTMENT OF MINES
OIL AND GAS DIVISION

1081

WELL RECORD

Permit No. 1235-A

Oil or Gas Well (KIND)

Company Brookland Supply Co
 Address W. Va.
 Farm Walter Acres _____
 Location (waters) _____
 Well No. 072 Elev. _____
 District Putnam County Putnam
 The surface of tract is owned in fee by _____
 Address _____
 Mineral rights are owned by _____
 Address _____
 Drilling commenced _____
 Drilling completed Oct 11 1908
 Date Shot _____ From _____ To _____
 With _____
 Open Flow _____ /10ths Water in _____ Inch
 _____ /10ths Merc. in _____ Inch
 Volume _____ Cu. Ft.
 Rock Pressure _____ lbs. _____ hrs.
 Oil _____ bbls., 1st 24 hrs.
 Fresh water _____ feet _____ feet
 Salt water _____ feet _____ feet

Casing and Tubing	Used in Drilling	Left in Well	Packers
Size			
16			Kind of Packer _____
13			
10		346	Size of <u>Port Wash</u>
8 1/2		55	
6 1/2	<input checked="" type="checkbox"/>	2170	Depth set _____
5 3/16		3115	
3			Perf. top _____
2			Perf. bottom _____
Liners Used			Perf. top _____
			Perf. bottom _____

CASING CEMENTED _____ SIZE _____ No. Ft. _____ Date _____
 COAL WAS ENCOUNTERED AT 690 FEET 48 INCHES
 _____ FEET _____ INCHES FEET _____ INCHES
 _____ FEET _____ INCHES FEET _____ INCHES

Formation	Color	Hard or Soft	Top	Bottom	Oil, Gas or Water	Depth Found	Remarks
Pop Coal			690	690			
Mudstone			1042	1100			
Salt			1740	1910			
Mudstone			1915	2060			
Pyritic			2105	2165			
Argillaceous			2165	2270			
Gauley			2475	2505			
30 ft			2671	2690			
Strat			2749	2774			
Inter				2778			

