



STATE OF WEST VIRGINIA
DEPARTMENT OF MINES
OIL AND GAS DIVISION

1068

WELL RECORD

Permit No. 107A

Oil or Gas Well Oil
(KIND)

Company The Interstate Pipe & Supply Company
Address P. O. Box 611, Marietta, Ohio
Farm D. E. Copenhaver Acres 72
Location (waters) Harris Fork
Well No. 1 Elev. 1341.93
District Eagle County Harrison
The surface of tract is owned in fee by Daniel Copenhaver
R. F. D. 3 Address Callado, West Va.
Mineral rights are owned by Miss Margaret Anne Tetrick
271 Clay Street Address Clarksburg, West Va.
Drilling commenced Oct. 2, 1908
Drilling completed Nov. 26, 1908
Date Shot 09, 10, 16 From 3148 To 3149
With _____


Casing and Tubing	Used in Drilling	Left in Well	Packers
Size			Kind of Packer
16			<u>Callahan Cave</u>
13			Size of
10	<u>150</u>	<u>none</u>	Depth set <u>2878</u>
8 1/4	<u>1542</u>	<u>none</u>	
6 1/2	<u>2278</u>	<u>2278</u>	
5 3/16	<u>2898</u>	<u>2898</u>	
3			Perf. top
2 tubing	<u>3150</u>	<u>3150</u>	Perf. bottom
Liners Used			Perf. top
<u>4 1/2 x 4</u>		<u>760</u>	Perf. bottom

Open Flow _____ /10ths Water in _____ Inch
_____ /10ths Merc. in _____ Inch
Volume _____ Cu. Ft.
Rock Pressure _____ lbs. _____ hrs.
Oil _____ bbls., 1st 24 hrs.
Fresh water _____ feet _____ feet
Salt water _____ feet _____ feet

CASING CEMENTED _____ SIZE _____ No. Ft. _____ Date _____
COAL WAS ENCOUNTERED AT 1033 FEET 60 INCHES
_____ FEET _____ INCHES _____ FEET _____ INCHES
_____ FEET _____ INCHES _____ FEET _____ INCHES

Formation	Color	Hard or Soft	Top	Bottom	Oil, Gas or Water	Depth Found	Remarks
Conductor				<u>16</u>			
Pittsburgh Coal			<u>1033</u>	<u>1038</u>			
Little Dunkard			<u>1381</u>	<u>1391</u>			
Big Dunkard			<u>1460</u>	<u>1491</u>			
Salt Gas Sand			<u>1720</u>	<u>1779</u>			
Water, Salt			<u>1840</u>	<u>2083</u>			
Big Lime			<u>2248</u>	<u>2293</u>			
Big Injun			<u>2293</u>	<u>2418</u>			
Fifty Foot			<u>2883</u>	<u>2925</u>			
Thirty Foot			<u>2975</u>	<u>2995</u>			
Stray Sand			<u>3071</u>	<u>3126</u>			
Gordon Sand			<u>3137</u>	<u>3163</u>			
1st Pay			<u>3151</u>				
Total Depth				<u>3164</u>			

11/7/16 -- Hung 260° of 4 1/2 F.J. Liner on Callahan Cave Packer. Top of Packer 2878°.

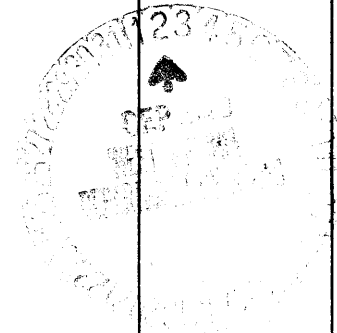

Formation	Color	Hard or Soft	Top	Bottom	Oil, Gas or Water	Depth Found	Remarks

Date September 1, 1948

APPROVED THE INTERSTATE PIPE & SUPPLY COMPANY, Owner

By Pipe Service Company
(Title)

D. E. COPENHAVER NO. 1 WELL.

1247A

Eagle District, Harrison County, W. Va.

By The Interstate Pipe & Supply Co., Box 611, Marietta, Ohio.

Abandoned under permit Har-.....-A?

On 72 acres, on Harris Fork.

Elevation, 1341.93' L.

Surface owned by Daniel Copenhaver, R. F. D. No. 3, Wallace, W. Va.,

and minerals by Miss Margaret Anne Tetrick, 271 Clay St.,

Clarksburg, W. Va.

Drilling commenced Oct. 2, 1908; completed Nov. 26, 1908.

Shot in 1909, 1910, and 1916, at 3148-3149'.

10" casing, 150' (pulled); 8 1/2", 1542' (pulled); 6 3/8", 2278'; 5", 2898';

2" tubing, 3150'; liner, 4 1/2" x 4", 2600'

11-7-16. Hung 260' of 4 1/2" x 4" F. J. liner on Callahan Cave Packer.

Top of packer, 2878'.

Coal was encountered at 1033-1038'.

Oil well. Abandonment reported to Dept. of Mines Sept. 1, 1948.

Record to BCT from Mrs. Griffith Jan. 22, 1949. Old File No. 1068.

	Top.	Bottom.
Conductor	0	16
Pittsburgh Coal	1033	1038
Little Dunkard Sand	1381	1391
Big Dunkard Sand	1460	1491
Salt Gas Sand	1720	1779
Water, Salt (Sand)	1840	2083
Big Line	2248	2293
Big Injun Sand	2293	2418
Fifty-foot Sand	2883	2925
Thirty-foot Sand	2975	2995
Stray Sand	3071	3126
Gordon Sand (1st pay, 3151')	3137	3163
Total depth		3164