

Surface: Chas. A. Pigoth, RFD # 3, Wallace Harrison Co. W. Va.
 Coal: Willis G. Tetrick, Jr. et al., 311 Clay St. Clarksburg W. Va.

New Location
 Drill Deeper
 Abandonment

On 400' map # 305A

S 1 E 8

Company Strauss & Beren
 Address Marietta Ohio
 Farm Alva Robinson
 Tract Acres 180 Lease No.
 Well (Farm) No. 4 Serial No.
 Elevation (Spirit Level) 1203.21
1202.72
 Quadrangle CLARKSBURG
 County Harrison District Sardis
 Engineer EC T. Abley
 Engineer's Registration No.
 Date July 21st 1925

STATE OF WEST VIRGINIA
 DEPARTMENT OF MINES
 OIL AND GAS DIVISION
 CHARLESTON

WELL LOCATION MAP
 FILE NO. HAR-1251-A

+ Denotes location of well on United States Topographic Maps, scale 1 to 12,500, latitude and longitude lines being represented by border lines as shown.

-- Denotes one inch spaces on border lines of original map.



STATE OF WEST VIRGINIA
DEPARTMENT OF MINES
OIL AND GAS DIVISION

1047

WELL RECORD

Permit No. 1751-A


Oil or Gas Well _____
(KIND)

Company Strauss & Beren
Address Marietta, Ohio
Farm Alva Robinson Acres 180
Location (waters) Big Elk
Well No. 4 Elev. 1205.22
District Sardis County Harrison
The surface of tract is owned in fee by Chas. A. Pigott
Address RFD # 3
Mineral rights are owned by Wallace W. Va. Willis G. Tetrick Jr.
et al Address 311 Clay Street,
Clarksburg, W. Va.
Drilling commenced _____
Drilling completed _____
Date Shot _____ From _____ To _____
With _____
Open Flow _____ /10ths Water in _____ Inch
_____ /10ths Merc. in _____ Inch
Volume _____ Cu. Ft.
Rock Pressure _____ lbs. _____ hrs.
Oil _____ bbls., 1st 24 hrs.
Fresh water _____ feet _____ feet
Salt water _____ feet _____ feet

Casing and Tubing	Used in Drilling	Left in Well	Packers
Size			
16			Kind of Packer
13			
10	385	none	Size of
8 1/4	1512	1512	
6%	2365	2365	Depth set
5 3/16			
3			Perf. top
2			Perf. bottom
Liners Used	333'	5x5 1/2"	Perf. top
	top at 2749'		Perf. bottom

CASING CEMENTED _____ SIZE _____ No. Ft. _____ Date _____
COAL WAS ENCOUNTERED AT 992 FEET _____ INCHES
_____ FEET _____ INCHES FEET _____ INCHES
_____ FEET _____ INCHES FEET _____ INCHES

Formation	Color	Hard or Soft	Top	Bottom	Oil, Gas or Water	Depth Found	Remarks
Pitts. Coal			992	997			
Little Dunkard			1392	1458			
Dunkard Sand			1480	1570			
Salt Sand			1740	1885			
Pencil Cave			2203	2208			
Big Lime			2208	2250			
Big Injun			2250	2360			
Gantz Sand			2710	2732			
Fifty Foot			2845	2890			
Boulder			2960	2979			
Stray Sand			3014	3064			
Gordon			3078	3108			
TOTAL DEPTH				3111			

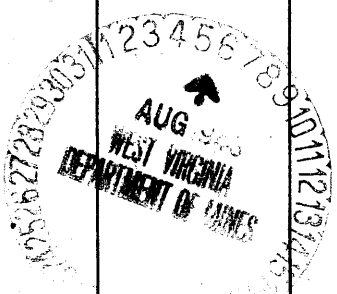

ALVA ROBINSON NO. 4 WELL.

Sardis District, Harrison County, W. Va.

By Strauss & Beren, Marietta, Ohio.

On 180 acres, on Elk Creek.

Elevation, 1205.22' L.

Surface owned by Chas. A. Pigott, R. F. D. No. 3, Wallace, W. Va., and minerals by Willis G. Tetrick, Jr., et al., 311 Clay St., Clarksburg, W. Va.

Date of completion not given.

10" casing, 385' (pulled); 8 $\frac{1}{4}$ "", 1512'; 6 $\frac{5}{8}$ "", 2365'; liner, 5x5 $\frac{1}{2}$ "", 333', top at 2749'.

Coal was encountered at 992-997'.

Oil well. Record to Dept. of Mines stamped Aug. 6, 1948.

Record to RGT from Mrs. Griffith Oct. 11, 1948. Old File No. 1047.

	Top.	Bottom.
Pittsburgh Coal	992	- 997
Little Dunkard Sand	1392	- 1458
Dunkard Sand	1480	- 1570
Salt Sand	1740	- 1885
Pencil Cave	2203	- 2208
Big Lime	2208	- 2250
Big Injun Sand	2250	- 2360
Gantz Sand	2710	- 2732
Fifty-foot Sand	2845	- 2890
Boulder Sand	2960	- 2979
Stray Sand	3014	- 3064
Gordon Sand	3078	- 3108
Total depth		3111

1251A