

1
2
3

Longitude 80° 25'

5 + + 2

New Location
Dred Deeper
Abandonment

Company Cris Eastern Service, Inc.
 Address Dolivar NY
 Farm U. T. Robinson
 Tract _____ Acres 118.88 Lease No. _____
 Well (Farm) No. 2 & 5 Serial No. _____
 Elevation (Spirit Level) _____
 Quadrangle CLARKSBURG
 County Harrison District Sardis
 Engineer Ernest C. Tabler
 Engineer's Registration No. 2005
 File No. _____ Drawing No. _____
 Date Oct 7th 1948 Scale 1" = 400 Feet

STATE OF WEST VIRGINIA
DEPARTMENT OF MINES
OIL AND GAS DIVISION
CHARLESTON

WELL LOCATION MAP

FILE NO. HAR-1268-A-#2
HAR-1269-A-#5

+ Denotes location of well on United States Topographic Maps, scale 1 to 62,500, latitude and longitude lines being represented by border lines as shown.

- Denotes one inch spaces on border line of original tracing.



STATE OF WEST VIRGINIA
DEPARTMENT OF MINES
OIL AND GAS DIVISION

1077

WELL RECORD


Permit No. 1268-A Oil or Gas Well Oil (KIND)

Company Otis Eastern Service, Inc.
Address Box 929, Charleston, W. Va.
Farm U. T. Robinson Acres 107
Location (waters) Big Elk
Well No. 2 Elev. _____
District Sardia County Harrison
The surface of tract is owned in fee by _____
Address _____
Mineral rights are owned by _____
Address _____
Drilling commenced July 7, 1904
Drilling completed Sept. 8, 1904
Date Shot _____ From _____ To _____
With _____
Open Flow _____ /10ths Water in _____ Inch
_____ /10ths Merc. in _____ Inch
Volume _____ Cu. Ft.
Rock Pressure _____ lbs. _____ hrs.
Oil 28 bbls., 1st 24 hrs.
Fresh water _____ feet _____ feet
Salt water _____ feet _____ feet

Casing and Tubing	Used in Drilling	Left in Well	Packers
Size			
16			Kind of Packer
13			
10	272	Pulled	Size of
8 1/4	1435'	1435'	
6 3/4	2440'	2440'	Depth set
5 3/16			
3			Perf. top
2	3164'	3164'	Perf. bottom
Liners Used	588'	588'	Perf. top
	(5" x 5 1/2")		Perf. bottom

CASING CEMENTED _____ SIZE _____ No. Ft. _____ Date _____
COAL WAS ENCOUNTERED AT 1035 FEET 60 INCHES
_____ FEET _____ INCHES FEET _____ INCHES
_____ FEET _____ INCHES FEET _____ INCHES

Formation	Color	Hard or Soft	Top	Bottom	Oil, Gas or Water	Depth Found	Remarks
Conductor				16			
Coal			1035	1040			
Dunkard Sand			1550	1650			
Salt Sand			1925	2030			
Big Lime			2255	2315			
Big Injun			2315	2415			
Fifty Foot			2925	2965			
Stray Sand			3042	3108			
Gordon Sand			3118	3148			
1st. Pay			3134				
Total Depth			3164				
Torpedo Record							
	<u>Date</u>	<u>Qts.</u>	<u>Shell</u>	<u>Top</u>	<u>Bottom</u>		
	12-22-08	20	4" x 20'	3133'			
	9-1-15	30	4" x 10'	3130'			
Packers							
	<u>Kind</u>	<u>Size</u>	<u>Depth</u>	<u>Date</u>			
	Liner	5 x 5 1/2"	2910'	Oct. 30, 1915			
	Liner	5 x 5 1/2"	2410'	Oct. 30, 1915			
Remarks							
Oct. 30, 1915 -- 5 x 5 1/2" Liner Packer set at 2910' - 10 jts. (211') 5 x 5 1/2" F.J. Liner hung on Packer, 6 jts. 124' - 5 x 5 1/2" F.J. Liner set on top of packer, Top of liner 2786'. Second section 253' (12 jts.) 5 x 5 1/2" F.J. liner hung on packer set at 2410' -							

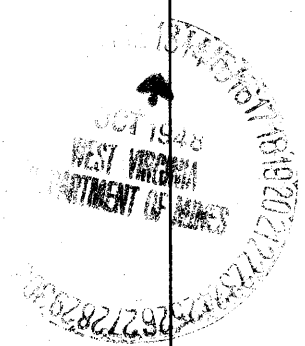

U. T. ROBINSON NO. 2 WELL.

1268A

Sardis District, Harrison County, W. Va.

By Otis Eastern Service, Inc., Box 929, Charleston, W. Va.

Abandoned under permit Har-.....-A7

On 107 acres, on Big Elk.

Elevation, ' L.

Drilling commenced July 7, 1904; completed Sept. 8, 1904.

Oil, 28 bbls., 1st 24 hrs.

10" casing, 272' (pulled); 8 $\frac{1}{2}$ ", 1435'; 6 $\frac{1}{2}$ ", 2410'; 2" tubing, 3164';
5 x 5 $\frac{1}{2}$ " liner, 538'.

Coal was encountered at 1035-1040'.

Shot Dec. 22, 1908, with 20 qts., 4" x 20' shell; top, 3133'.

Shot Sept. 1, 1915, with 30 qts., 4" x 10' shell; top, 3130'.

Packers: Liner, 5 x 5 $\frac{1}{2}$ ", 2910', Oct. 30, 1915; liner, 5 x 5 $\frac{1}{2}$ ", 2410',
Oct. 30, 1915.

Remarks: Oct. 30, 1915. 5 x 5 $\frac{1}{2}$ " liner packer set at 2910' - 10 jts.
(211') 5 x 5 $\frac{1}{2}$ " F. J. liner hung on packer; 6 jrs. (124') 5 x 5 $\frac{1}{2}$ "
F. J. liner set on top of packer. Top of liner, 2786'. Second
section, 253' (12 jts.) 5 x 5 $\frac{1}{2}$ " F. J. liner hung on packer, set
at 2410'.

Oil well. Record to Dept. of Mines stamped Oct. 13, 1948.

Record to NCT from Mrs. Griffith Jan. 28, 1949. Old File No. 1077.

	Top.	Bottom.
Conductor	0	16
Coal	1035	1040
Dunkard Sand	1550	1650
Salt Sand	1925	2030
Big Line	2255	2315
Big Injun Sand	2315	2415
Fifty-foot Sand	2925	2965
Stray Sand	3042	3108
Gordon Sand (1st pay, 334')	3118	3148
Total depth		3164