

Company F. G. Bish

Address Clarksburg, W. Va.

Farm O. B. Lawman

Tract 1 Acres 272.7 Lease No. _____

Well (Farm) No. 1 Serial No. _____

Elevation (Spirit Level) 1162

Quadrangle Clarksburg

County Harrison District Clark

Engineer M. L. B. Linger

Engineer's Registration No. 261

File No. _____ Drawing No. _____

Date October 20, 1949 Scale 1" = 600'

STATE OF WEST VIRGINIA
DEPARTMENT OF MINES
OIL AND GAS DIVISION
CHARLESTON

WELL LOCATION MAP

FILE NO. HAR-1277-A 711

+ Denotes location of well on United States Topographic Maps, scale 1 to 62,500, latitude and longitude lines being represented by border lines as shown.

- Denotes one inch spaces on border line of original tracing.

WEST VIRGINIA DEPARTMENT OF MINES
OIL AND GAS DIVISION

1055

WELL RECORD

Permit No. Ab 1077-A

Oil or Gas Well (Kind)

Company	F G Bish	Casing and Tubing	Used in Drilling	Left in Well	Packers
Address	Box 428 Clarksburg W Va	Size			
Farm	O B Lawman Acres	16			Kind of Packer
Location (waters)	West Fork River	13			
Well No.	1 Elev	10	152	152	Size of
District	Clark County Harrison	8 1/4	968	968	Depth set
The surface of tract is owned in fee by	O B Lawman	5 3/16	1397	1397	Perf. top
Address	Stealey Ave Clarksburg W Va	3	2129	2129	Perf. bottom
Mineral rights are owned by	O B Lawman & Archie	Liners Used			Perf. top
Address	Clarksburg W Va Stealey Ave	2			Perf. bottom
Drilling commenced					
Drilling completed					
Date shot	Depth of shot				
Open Flow	/10ths Water in				
	/10ths Merc. in				
Volume	Cu. Ft.				
Rock Pressure	lbs.				
Oil	bbls., 1st 24 hrs.				
Fresh water	feet				
Salt water	feet				


CASING CEMENTED _____ SIZE _____ No. FT. _____ Date _____

COAL WAS ENCOUNTERED AT **No Coal** FEET _____ INCHES _____

FEET _____ INCHES _____ FEET _____ INCHES _____

FEET _____ INCHES _____ FEET _____ INCHES _____

Formation	Color	Hard or Soft	Top	Bottom	Oil Gas or Water	Depth Found	Remarks
Big Dunkard			505		555	Water 670	
Salt Sand			651		686		
" "			735		828		
2 2			851		982	Gas 870	
Maxon			1203		1228		
Big Lime			1310		1366		
Big Injun			1366		1481	Gas 1410	
50 ft			1848		1885		
30 ft			1892		1919		
Gordon			2113		2152	Gas 2130	
4th			2203		2229		
5th			2267		2291	Gas 2273-81	
Total Depth					2303		

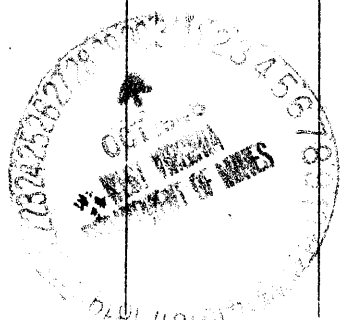

O. B. LAWMAN NO. 1 WELL.

Clark District, Harrison County, W. Va.
By F. G. Bish, Box 428, Clarksburg, W. Va.
Abandoned under permit Har-.....-A?
On.....acres, on West Fork River.
Elevation, ' L.

1277A

Surface owned by O. B. Lawman, Stealey Ave., Clarksburg, W. Va., and
minerals by O. B. Lawman and Archie Hall, Stealey Ave., Clarksburg, W. Va.

Date of completion not given.

Salt water at 670 and 870' (?).

10" casing, 152'; 8 $\frac{1}{4}$ "", 968'; 6 $\frac{5}{8}$ "", 1397'; 5 $\frac{3}{16}$ "", 2129'; all left in.

No coal was encountered.

Gas well. Record to Dept. of Mines stamped Oct. 29, 1948.

Record to RCT from Mrs. Griffith Jan. 5, 1949. Old File No. 1055.

	Top.	Bottom.
Big Dunkard Sand	505	- 555
Salt Sand (water, 670')	651	- 686
Salt Sand	735	- 828
2nd Salt Sand (gas, 870')	851	- 982
Maxton Sand	1203	- 1228
Big Lime	1310	- 1366
Big Injun Sand (gas, 1410')	1366	- 1481
50-Ft. Sand	1848	- 1885
30-Ft. Sand	1892	- 1919
Gordon Sand (gas, 2130')	2113	- 2152
4th Sand	2203	- 2229
5th Sand (gas, 2273-81')	2267	- 2291
Total depth		2303