

Surface: Lake Floyd Club.  
 Address: Fred Deem, Sect. Empire Bank Bldg., Clarksburg, W.Va.  
 Coal: Nathan Goff Estate.  
 Address: Ernest Swiger, Agent, Goff Bldg., Clarksburg, W.Va.

New Location   
 Drill Deeper   
 Abandonment  On AOO map # 3653.

N12-13 ET

Company Wm Moses  
 Address Salem, W.Va.  
 Farm Nathan Goff  
 Tract Acres 641 3/8 Lease No. \_\_\_\_\_  
 Well (Farm) No. 28 Serial No. \_\_\_\_\_  
 Elevation (Spirit Level) Floor 1210.50  
 Ground 1209.00  
 Quadrangle CENTERPOINT  
 County Harrison District Ten Mile  
 Engineer E.C. Tabler  
 Engineer's Registration No. \_\_\_\_\_  
 File No. \_\_\_\_\_ Drawing No. \_\_\_\_\_  
 Date August 6<sup>th</sup> 1948 Scale 1" = 800 Feet

STATE OF WEST VIRGINIA  
 DEPARTMENT OF MINES  
 OIL AND GAS DIVISION  
 CHARLESTON

WELL LOCATION MAP  
 FILE NO. HAR-1293-A

+ Denotes location of well on United States Topographic Maps, scale 1 to 62,500, latitude and longitude lines being represented by border lines as shown.  
 - Denotes one inch spaces on border line of original tracing.



STATE OF WEST VIRGINIA  
DEPARTMENT OF MINES  
OIL AND GAS DIVISION

1070

WELL RECORD

Permit No. Ab 1793 A

Oil or Gas Well Oil

(KIND)


Company <u>William Moses</u>	Casing and Tubing	Used in Drilling	Left in Well	Packers
Address <u>Salem, W. Va.</u>	Size			
Farm <u>Nathan Goff</u> Acres <u>641</u>	16			Kind of Packer
Location (waters)	13			
Well No. <u>twenty-eight</u> Elev. <u>1210.50</u>	10			Size of
District <u>Tennile</u> County <u>Harrison</u>	8 1/4			
The surface of tract is owned in fee by <u>South Penn Gas Co.</u>	6%		<u>1944</u>	Depth set
Address <u>Parkersburg</u>	5 3/16			
Mineral rights are owned by <u>Nathan Goff, Estate</u>	3			Perf. top
<u>Goff Building</u> Address <u>Clarksburg, W. Va.</u>	2			Perf. bottom
Drilling commenced <u>No Data</u>	Liners Used			Perf. top
Drilling completed				Perf. bottom
Date Shot From To				
With				
Open Flow /10ths Water in Inch	CASING CEMENTED SIZE No. Ft. Date			
/10ths Merc. in Inch				
Volume Cu. Ft.				
Rock Pressure lbs. hrs.	COAL WAS ENCOUNTERED AT <u>588</u> FEET INCHES			
Oil bbls., 1st 24 hrs.	FEET INCHES FEET INCHES			
Fresh water feet feet	FEET INCHES FEET INCHES			
Salt water feet feet				

Formation	Color	Hard or Soft	Top	Bottom	Oil, Gas or Water	Depth Found	Remarks
Pitts. Coal			588	--			
Gordon Sand			2655	--			
Fifth Sand			2888	--			
Total Depth			2926.				

Dear Mrs. Griffith:

The above is all the record which the South Penn has of this well, and I cannot make a work order for it with no more to go on than this. If you can make me one for this well, I would appreciate it very much. If so, please send me a copy of the work order so that I can mail it to the coal owner

Resp. Yours,  
*Geo. Moses*  
 Geo. Moses.

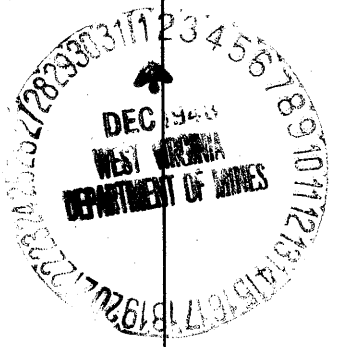

NATHAN GOFF NO. 28 WELL.

Tennile District, Harrison County, W. Va.

1293A

By William Moses, Salem, W. Va.

Abandoned under permit Har-.....-A?

On 641 acres.

Elevation, 1210.50' L.

Surface owned by South Penn Natural Gas Co., Parkersburg, W. Va., and  
minerals by Nathan Goff Estate, Goff Bldg., Clarksburg, W. Va.

Date of completion, etc., not given.

6<sup>3</sup>/<sub>8</sub>" casing, 1944.

Coal was encountered at 588'.

Oil well. Record to Dept. of Mines stamped Dec. 1, 1948.

Record to RCT from Mrs. Griffith Jan. 22, 1949. Old File No. 1070.

	Top.	Bottom.
Pittsburgh Coal	588	- ...
Gordon Sand	2655	- ....
Fifth Sand	2888	- ....
Total depth		2926