

Surface: Brooks Hutson, R.F.D. No. 1, Wallace, W. Va.
 Coal: Miss Margaret Anne Tetrick,
 Address: % W. Guy Tetrick, P.O. Box 267, Clarksburg, W. Va.

New Location
 Drill Deeper
 Abandonment

on 400 Map Sheet No. 3153, Sqs. 5 3 E 6.

5.70 S
 0.83 W

Company Otis Eastern Service, Inc.
 % Edgar L. Thompson
 Address P.O. Box 929, Charleston, W. Va.
 Farm M.P. Dye
 Tract _____ Acres 188.66 Lease No. _____
 Well (Farm) No. 3 Serial No. _____
 Elevation (Spirit Level) Floor - 1427.33
Ground - 1424.83
 Quadrangle Centerpoint
 County Harrison District Sardis
 Engineer Mr. S. Hayes
 Engineer's Registration No. 1429
 File No. _____ Drawing No. _____
 Date Nov. 4th, 1948 Scale 1" = 800 Feet

STATE OF WEST VIRGINIA
 DEPARTMENT OF MINES
 OIL AND GAS DIVISION
 CHARLESTON

WELL LOCATION MAP
 FILE NO. HAR-1295-A

+ Denotes location of well on United States Topographic Maps, scale 1 to 62,500, latitude and longitude lines being represented by border lines as shown.

- Denotes one inch spaces on border line of original tracing.



STATE OF WEST VIRGINIA
DEPARTMENT OF MINES
OIL AND GAS DIVISION

1085

WELL RECORD

Permit No. AD 1745-A

Oil or Gas Well Oil
(KIND)

Company Otis Eastern Service, Inc.
Address Box 929, Charleston, W. Va.
Farm M. P. Dye (Treat Pur.) Acres 210
Location (waters) Ten Mile
Well No. 3 Elev. _____
District Sardis County Harrison
The surface of tract is owned in fee by _____
Address _____
Mineral rights are owned by _____
Address _____
Drilling commenced _____
Drilling completed December 9, 1907
Date Shot _____ From _____ To _____
With _____
Open Flow _____ /10ths Water in _____ Inch
_____ /10ths Merc. in _____ Inch
Volume _____ Cu. Ft.
Rock Pressure _____ lbs. _____ hrs.
Oil _____ 125 bbls., 1st 24 hrs.
Fresh water _____ feet _____ feet
Salt water _____ feet _____ feet

Casing and Tubing	Used in Drilling	Left in Well	Packers
Size			
16			Kind of Packer _____
13			
10	200'	Pulled	Size of _____
8 1/4	1686'	1686'	
6 5/8	2442'	2442'	Depth set _____
5 3/16	3216'	3216'	
3			Perf. top _____
2" UE	3315	3315	Perf. bottom _____
Liners Used			Perf. top _____
			Perf. bottom _____

CASING CEMENTED _____ SIZE _____ No. Ft. _____ Date _____

COAL WAS ENCOUNTERED AT 1217 FEET 72 INCHES


FEET INCHES FEET INCHES

FEET INCHES FEET INCHES

Formation	Color	Hard or Soft	Top	Bottom	Oil, Gas or Water	Depth Found	Remarks
Conductor				16			
Pittsburgh Coal			1217	1223			
Big Lime			2442	2448			
Pencil Cave			2439	2442			
Big Injun			2448	2635			
Gordon Stray			3215	3270			
Gordon Sand			3281	3305			
1st Pay			3284	3287			
2nd. Pay			3300	3304			
Total Depth				3315			
(Hole drilled to 3215)							
Present total depth				3215			

Torpedo Record

Date	Qts.
6-21-08	8
2-27-08	15
10-25-09	15

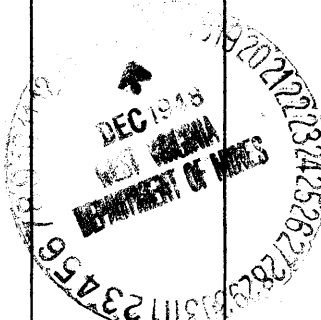

M. P. DYE (TREAT PUR.) NO. 3 WELL.

1295A

Sardis District, Harrison County, W. Va.

By Otis Eastern Service, Inc., Box 929, Charleston, W. Va.

Abandoned under permit Har-----A?

On 210 acres, on Fennille Creek.

Elevation,.....' L.

Drilling completed Dec. 9, 1907.

Shot June 21, 1908, with 8 qts.; Feb. 27, 1908, with 15 qts.; and

Oct. 25, 1909, with 15 qts.

Oil, 125 bbls., 1st 24 hrs.

10" casing, 200' (pulled); 8 1/2", 1686' (pulled); 6 3/4", 2442'; 5", 3216';

2" U. E. tubing, 3315'.

Coal was encountered at 1217-1223'.

Oil well. Record to Dept. of Mines stamped Dec. 15, 1948.

Record to RCT from Mrs. Griffith Feb. 3, 1949. Old File No. 1085.

	Top.	Bottom.
Conductor	0	16
Pittsburgh Coal	1217	1223
Big Lime	2442	2448
Pencil Cave ///	2439	2442
Big Injun Sand	2448	2635
Gordon Stray Sand	3300-3304'	3215 - 3270
Gordon Sand (1st pay, 3284-3287'; 2nd pay, /3281		3215 - 3305
Total depth		3315
Hole filled to		3215