

Surface: Ellis Williams RFD No. 1 Bristol, W. Va.

Coal: Willis G. Tetrick Jr. Address: P.O. Box 267 Clarksburg W. Va.

New Location
 Drill Deeper
 Abandonment On 400 Map Sheet 3554 Sq. S10 E 9.

Company C. R. DeLay
 Address Hamlin, W. Va.
 Farm Loverna Williams
 Tract _____ Acres 58 1/2 Lease No. _____
 Well Farm No. 3 Serial No. _____
 Elevation (Spot Level) Floor - 046.13
Ground 1045.13
 Quadrange Clarksburg
 County Harrison District Tenmile
 Engineer Mr. S. Hayes
 Engineer's Registration No. 429
 File No. _____ Drawing No. _____
 Date Oct. 20th, 1948 Scale 1" = 400 feet

STATE OF WEST VIRGINIA
 DEPARTMENT OF MINES
 OIL AND GAS DIVISION
 CHARLESTON

WELL LOCATION MAP
 FILE NO. HAR 13018

+ Denotes location of well on United States Topographic Maps, scale 1 to 62,500. Latitude and longitude lines are represented by border lines as shown.
 - Denotes one-half acre or less of acreage of one tract.



STATE OF WEST VIRGINIA
DEPARTMENT OF MINES
OIL AND GAS DIVISION

1118

WELL RECORD

Permit No. As 1301-A

Oil or Gas Well _____ (KIND)

Company South Penn Natural Gas Co.
 Address Parkersburg, W. Va.
 Farm Loverna Williams Acres 58 1/2
 Location (waters) _____
 Well No. 3 Elev. _____
 District Tennile County Harrison
 The surface of tract is owned in fee by _____
 Address _____
 Mineral rights are owned by _____
 Address _____
 Drilling commenced _____
 Drilling completed April 17, 1900
 Date Shot _____ From _____ To _____
 With _____
 Open Flow _____ /10ths Water in _____ Inch
 _____ /10ths Merc. in _____ Inch
 Volume _____ Cu. Ft.
 Rock Pressure _____ lbs. _____ hrs.
 Oil _____ bbls., 1st 24 hrs.
 Fresh water _____ feet _____ feet
 Salt water _____ feet _____ feet


Casing and Tubing	Used in Drilling	Left in Well	Packers
Size			
16			Kind of Packer
13			
10			Size of
8 3/4			
6 5/8		1722	Depth set
5 3/16			
3			Perf. top
2			Perf. bottom
Liners Used			Perf. top
			Perf. bottom

CASING CEMENTED _____ SIZE _____ No. Ft. _____ Date _____

COAL WAS ENCOUNTERED AT _____ FEET _____ INCHES
 _____ FEET _____ INCHES FEET _____ INCHES
 _____ FEET _____ INCHES FEET _____ INCHES

Formation	Color	Hard or Soft	Top	Bottom	Oil, Gas or Water	Depth Found	Remarks
Pgh Coal			170	178			
Dunkard			730	800			
Gas Sand			1480	1520			
Maxom			1570	1590			
Big Lime			1590	1650			
Big Injun			1650	1700			
Fifty Foot			2200	2225			
Gordon Sand			2370	2396			
Fifth Sand			2537	2549			
Total Depth				2559			
Filled to				2534			
Initial Prod.							
Fifth Sand -- 60 bbls							
							Supt.

Packer
None
 Torpedo Record
 1900 -- 40 qts.
 1901 -- 40 qts.
 LINER RECORD
 425'-5" X 5 1/8" Liner

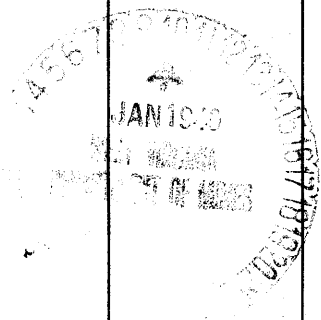

LOVERNA WILLIAMS NO. 3 WELL.

Tennile District, Harrison County, W. Va.
 By South Penn Natural Gas Co., Parkersburg, W. Va.
 Abandoned under permit Har-.....-A?
 On 58½ acres.

1301A

Elevation,' L.

Drilling completed April 17, 1900.

Oil, 60 bbls., 1st 24 hrs. (Fifth Sand).

6½" casing, 1722'; 5x5½" liner, 425'.

Oil well. Record to Dept. of Mines stamped Jan. 10, 1949.

Tracker, none.

Shot in 1900, with 40 qts.; in 1901, with 40 qts.

Record to RCT from Mrs. Griffith April 18, 1949. Old File No. 1118.

	Top.	Bottom.
Pittsburgh Coal	170	- 178
Dunkard Sand	730	- 800
Gas Sand	1480	- 1520
Maxton Sand	1570	- 1590
Big Lime	1590	- 1650
Big Injun Sand	1650	- 1700
Fifty-foot Sand	2200	- 2225
Gordon Sand	2370	- 2396
Fifth Sand	2537	- 2549
Total depth		2559
Filled to		2534