

New Location
 Drill Deeper
 Abandonment

Surface owned by Kenneth Mittong, Lake Floyd, Bristol, W. Va.
 Cool thought to be owned by W. Guy Tetrick, Clarksburg, W. Va.

Company ROHE CASING CO.
 Address Hamlin, W. Va.
 Farm Law, Darnold Lease
 Tract Acres 14 Lease No. 58
 Well (Farm) No. Two Serial No.
 Elevation (Spirit Level) 1070
 Quadrangle Centerpoint
 County Harrison District Tenmile
 Engineer W. Stoltz
 Engineer's Registration No. 1227
 File No. Drawing No.
 Date March, 1949 Scale 1" = 300'

STATE OF WEST VIRGINIA
 DEPARTMENT OF MINES
 OIL AND GAS DIVISION
 CHARLESTON

WELL LOCATION MAP
 FILE NO. HAR-1325-A

+ Denotes location of well on United States Topographic Maps, scale 1 to 62,500, latitude and longitude lines being represented by border lines as shown.

- Denotes one inch spaces on border line of original tracing.



STATE OF WEST VIRGINIA
DEPARTMENT OF MINES
OIL AND GAS DIVISION

1128

Permit No. 1325-A

WELL RECORD

Oil or Gas Well X (KIND)

Company South Penn Natural Gas Co.
Address Parkersburg, W. Va.
Farm Law Darnold Well Acres 98
Location (waters) _____
Well No. 2 Elev. _____
District Termile County Harrison
The surface of tract is owned in fee by _____
Address _____
Mineral rights are owned by _____
Address _____

Drilling commenced _____
Drilling completed Dec. 27, 1905
Date Shot _____ From _____ To _____
With _____


Open Flow _____ /10ths Water in _____ Inch
_____ /10ths Merc. in _____ Inch
Volume _____ Cu. Ft.
Rock Pressure _____ lbs. _____ hrs.
Oil 75 _____ bbls., 1st 24 hrs.
Fresh water _____ feet _____ feet
Salt water _____ feet _____ feet

Casing and Tubing	Used in Drilling	Left in Well	Packers
Size			Kind of Packer
16			
13			
10		1 55	Size of
8 1/4		1360	
6 5/8		2340	Depth set
5 3/16			
3			Perf. top
2			Perf. bottom
Liners Used			Perf. top
			Perf. bottom

CASING CEMENTED _____ SIZE _____ No. Ft. _____ Date _____

COAL WAS ENCOUNTERED AT _____ FEET _____ INCHES
_____ FEET _____ INCHES FEET _____ INCHES
_____ FEET _____ INCHES FEET _____ INCHES

Formation	Color	Hard or Soft	Top	Bottom	Oil, Gas or Water	Depth Found	Remarks
High Coal			850	855			
Dunkard Sand			1360	1450			
Salt Sand			1820	1900			
Big Lime			2100	2160			
Big Injun			2 160	2260			
Fifty Foot			2710	2725			
Thirty Foot			2815	2830			
Stray Sand			2886	2894			PACKERS See remarks
Gordon Sand			2908	2930			
1st pay			2919				
Total depth				2936			TORPEDO RECORD 1905-- 10qts. -- 2920 1906-- 20 " -- 2919 1909-- 40 " -- 2918
Initial Prod.							
Gordon Sand --25 bbls							Remarks: Feb. 7, 1907 240' - 5" X 5 1/2" F. J. Cag Liner, set on shoulder at top of Gordon Sand Callahan Cave Packer on top of liner. Top 2668' Bottom Jt. perforated
							Supt. Buffalo Dist. #8

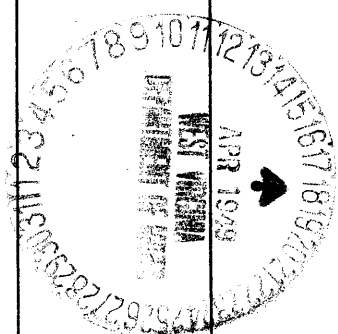

Law Darnold?
LAW DARNOLD NO. 2 WELL.

1325A

Tennile District, Harrison County, W. Va.
By South Penn Natural Gas Co., Parkersburg, W. Va.
Abandoned under permit Har-.....-A?
On 98 acres.

Elevation,' L.

Drilling completed Dec. 23, 1905.

Oil, 25 bbls., 1st 24 hrs.

10" casing, 155'; 8 $\frac{1}{4}$ " 1360'; 6 $\frac{5}{8}$ " 2340'; all left in.

Terpedo record: 1905, 10 qts., 2920'; 1906, 20 qts., 2919'; 1909, 40 qts., 2918'.

Remarks: Feb. 7, 1907. 240' - 5x5 $\frac{1}{8}$ " F. J. casing liner, set on shoulder at top of Gordon Sand. Callahan cave packer on top of liner. Top, 2668'. Bottom joint perforated.

Oil well. Abandonment reported to Dept. of Mines (stamped) Apr. 18, 1949.
Record to RCT from Mrs. Griffith July 10, 1949. Old File No. 1128.

	Top.	Bottom.
Pittsburgh Coal	850	- 855
Dunkard Sand	1360	- 1450
Salt Sand	1820	- 1900
Big Lime	2100	- 2160
Big Injun Sand	2160	- 2260
Fifty-foot Sand	2710	- 2725
Thirty-foot Sand	2815	- 2830
Stray Sand	2886	- 2894
Gordon Sand (1st pay, 2919')	2908	- 2930
Total depth		2936