

New Location
 Drill Deeper
 Abandonment

South Penn Map N-39 S-7 E-8

Surface owned by C.E. Harbert, whose address is Route No 2, Wallace, West Va.
 Coal owned by the Tetrick Interests Address Willis G. Tetrick, Jr., Clarksburg, W. Va.

Company ROHE CASING CO.
 Address Hamlin, W. Va.
 Farm John Harbert
 Tract _____ Acres 79 1/2 Lease No. _____
 Well (Farm) No. One Serial No. _____ **WC**
 Elevation (Spirit Level) 1290'
 Quadrangle Clarksburg
 County Harrison District Sardis
 Engineer W. H. Hoetz
 Engineer's Registration No. 1227
 File No. _____ Drawing No. _____
 Date February, 1949 Scale 1" = 500'

STATE OF WEST VIRGINIA
 DEPARTMENT OF MINES
 OIL AND GAS DIVISION
 CHARLESTON

WELL LOCATION MAP
 FILE NO. HAR-1329-A

+ Denotes location of well on United States Topographic Maps, scale 1 to 62,500, latitude and longitude lines being represented by border lines as shown.
 - Denotes one inch spaces on border line of original tracing.

JOHN HARBERT NO. 1 WELL.

1328A

Hardis District, Harrison County, W. Va.
 By South Penn Natural Gas Co., Parkersburg, W. Va.
 Abandoned under permit Har-.....-A?

On 79 $\frac{1}{2}$ acres.

Elevation,' L.

Drilling completed April 1911.

Initial production, Gordon Sand, 25 bbls.

10" and 8 $\frac{1}{2}$ " pulled; 6 $\frac{1}{2}$ " casing, 2037'; 5 $\frac{1}{2}$ ", 2068'.

Packer, 6 $\frac{1}{2}$ x 5 $\frac{1}{2}$ O. W. D. W., installed with 5" casing in 1934.

Remarks: 600' of 5" casing liner, 3 sections; hole reduced at 2811'.

Oil well. Record to Dept. of Mines stamped May 6, 1949.

Record to RCT from Mrs. Griffith September 14, 1949. Old File No. 1149.

	Top.	Bottom.
Pittsburgh Coal	759	764
Big Dunkard Sand	1226	1275
Salt Sand	1450	1540
Maxton Sand	1945	2030
Fifty-foot Sand	2670
Thirty-foot Sand	2730	2750
Stray Sand	2770	2790
Gordon Sand (gas, 2734') (1st pay, oil, 2845')	2807	2865
Total depth		2866



STATE OF WEST VIRGINIA
DEPARTMENT OF MINES
OIL AND GAS DIVISION

1149

WELL RECORD

Permit No. 13084 Oil or Gas Well Oil (KIND)

Company South Penn Natural Gas Co.
Address Parkersburg, W. Va.
Farm John Harbert Acres 79-1/2
Location (waters) _____
Well No. 1 Elev. _____
District Sardia County Harrison
The surface of tract is owned in fee by _____
Address _____
Mineral rights are owned by _____
Address _____

Casing and Tubing	Used in Drilling	Left in Well	Packers
Size			Kind of Packer
16			
13			
10		--	Size of
8 1/4		--	
6 5/8		2037	Depth set
5 3/16		2068	
3			Perf. top
2			Perf. bottom
Liners Used			Perf. top
			Perf. bottom

Drilling commenced _____
Drilling completed April, 1911
Date Shot _____ From _____ To _____
With _____
Open Flow _____ /10ths Water in _____ Inch
_____ /10ths Merc. in _____ Inch
Volume _____ Cu. Ft.
Rock Pressure _____ lbs. _____ hrs.
Oil _____ bbls., 1st 24 hrs.
Fresh water _____ feet _____ feet
Salt water _____ feet _____ feet


CASING CEMENTED _____ SIZE _____ No. Ft. _____ Date _____
COAL WAS ENCOUNTERED AT _____ FEET _____ INCHES
_____ FEET _____ INCHES FEET _____ INCHES
_____ FEET _____ INCHES FEET _____ INCHES

Formation	Color	Hard or Soft	Top	Bottom	Oil, Gas or Water	Depth Found	Remarks
Pgh Coal			759	764			
Big Dunkard			1226	1275			
Salt Sand			1450	1540			
Maxon Sand			1945	2030			
Fifty Foot			2670	----			
Thirty Foot			2730	2750			
Stray Sand			2770	2790			
Gordon Sand			2807	2865			
Gas			2734	--			
1st pay			2845	--011			
Total depth			2866				

Packer Record
6-5/8" X 5-3/16" O. W. U. W.
Packer Installed with 5-3/16"
Csg. in 1934

Remarks: 600' - 5-3/16" Casing
liner 3 sections Hole reduced
at 2811

Initial Production
Gordon Sand -- 25 bbls
Maxon

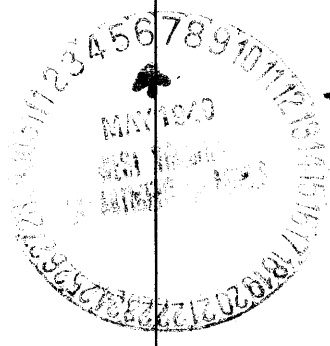

Supt.