

New Location   
 Drill Deeper   
 Abandonment

Surface owned by Mrs. Rebecca Fultz,  
 Route 1, Wolf Summit, W. Va.  
 Coal - W.G. Tetrick, Clarksburg, W. Va.

Company ROHE CASING CO.  
 Address Hamlin, West Virginia  
 Farm J.M. Fultz  
 Tract \_\_\_\_\_ Acres 12 1/2 Lease No. \_\_\_\_\_  
 Well (Farm) No. Seven Serial No. SE  
 Elevation (Spirit Level) 1220'  
 Quadrangle Centerpoint  
 County Harrison District Tenmile  
 Engineer [Signature]  
 Engineer's Registration No. 1227  
 File No. \_\_\_\_\_ Drawing No. \_\_\_\_\_  
 Date June, 1949 Scale 1" = 600'

STATE OF WEST VIRGINIA  
 DEPARTMENT OF MINES  
 OIL AND GAS DIVISION  
 CHARLESTON

**WELL LOCATION MAP**  
 FILE NO. HAR-1346-A

+ Denotes location of well on United States Topographic Maps, scale 1 to 62,500, latitude and longitude lines being represented by border lines as shown.  
 - Denotes one inch spaces on border line of original tracing.



STATE OF WEST VIRGINIA  
DEPARTMENT OF MINES  
OIL AND GAS DIVISION

1161

## WELL RECORD

Permit No. 1346-A

Oil or Gas Well \_\_\_\_\_  
(KIND)


Company South Penn Natural Gas Co.  
 Address Parkersburg, W. Va.  
 Farm J. M. Voltz Acres 146  
 Location (waters) \_\_\_\_\_  
 Well No. 7 Elev. \_\_\_\_\_  
 District Tennile County Harrison  
 The surface of tract is owned in fee by \_\_\_\_\_  
 Address \_\_\_\_\_  
 Mineral rights are owned by \_\_\_\_\_  
 Address \_\_\_\_\_  
 Drilling commenced \_\_\_\_\_  
 Drilling completed Aug. 15, 1949  
 Date Shot \_\_\_\_\_ From \_\_\_\_\_ To \_\_\_\_\_  
 With \_\_\_\_\_  
 Open Flow \_\_\_\_\_ /10ths Water in \_\_\_\_\_ Inch  
 \_\_\_\_\_ /10ths Merc. in \_\_\_\_\_ Inch  
 Volume \_\_\_\_\_ Cu. Ft.  
 Rock Pressure \_\_\_\_\_ lbs. \_\_\_\_\_ hrs.  
 Oil \_\_\_\_\_ bbls., 1st 24 hrs.  
 Fresh water \_\_\_\_\_ feet \_\_\_\_\_ feet  
 Salt water \_\_\_\_\_ feet \_\_\_\_\_ feet

Casing and Tubing	Used in Drilling	Left in Well	Packers
Size			Kind of Packer
16			
13			
10			Size of
8 1/4			
6 5/8		2036	Depth set
5 3/16		294	
3			Perf. top
2			Perf. bottom
Liners Used			Perf. top
			Perf. bottom

CASING CEMENTED \_\_\_\_\_ SIZE \_\_\_\_\_ No. Ft. \_\_\_\_\_ Date \_\_\_\_\_

COAL WAS ENCOUNTERED AT \_\_\_\_\_ FEET \_\_\_\_\_ INCHES  
 \_\_\_\_\_ FEET \_\_\_\_\_ INCHES \_\_\_\_\_ FEET \_\_\_\_\_ INCHES  
 \_\_\_\_\_ FEET \_\_\_\_\_ INCHES \_\_\_\_\_ FEET \_\_\_\_\_ INCHES

Formation	Color	Hard or Soft	Top	Bottom	Oil, Gas or Water	Depth Found	Remarks
Pgh Coal			606	612			
Big Injun			2003	2082			
Gordon Sand			2661	2722			
Fifth Sand			2909	2915			
Total Depth				2937			
Initial production							
1st Sand		45 bbls					
					Packers "pang Disc Wall 6-5/8x5-3/16" Depth 294  Torpedo Record 1901 24 qts. 1905 24 qts.		
							upt.

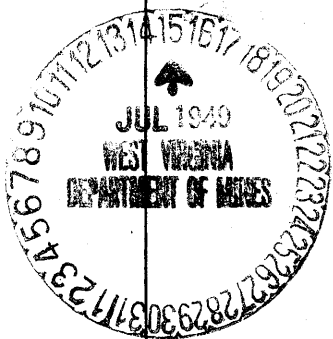

J. M. FULTZ NO. 7 WELL.

1346A

Tennile District, Harrison County, W. Va.  
By South Penn Natural Gas Co., Parkersburg, W. Va.  
Abandoned under permit Har-.....-A?

On 146 acres.

Elevation, .....' L.

Drilling completed Aug. 16, 1900.

Oil, 45 bbls., 1st 24 hrs.

6 $\frac{5}{8}$ " casing, 2036'; 5 $\frac{3}{8}$ ", 294'; all left in.

Packers: Spang disc wall, 6 $\frac{5}{8}$  x 5 $\frac{3}{8}$ ; depth, 294'.

Torpedo record: 1901, 24 qts.; 1905, 24 qts.

Oil well. Record to Dept. of Mines stamped July 15, 1949.

Record to RCT from Mrs. Griffith Nov. 4, 1949. Old File No. 1161.

Pittsburgh Coal

Big Injun Sand

Gordon Sand

Fifth Sand (oil, 45 bbls.)

Total depth

Top. Bottom.

606 - 612

2003 - 2082

2661 - 2722

2909 - 2916

2937