

#5272 4.33 S
1.16 W

#1404 4.31 S
0.90 W

New Location
 Drill Deeper
 Abandonment 5272

Map Sheet 43, Squares 513 E 19 F B, 514 P 29-30

Company Hope Natural Gas Co.
 Address Clarksburg, W. Va.
 Farm L.E. Stout
 Tract _____ Acres 130 Lease No. 5012
 Well (Farm) No. _____ Serial No. 1404-5272
 Elevation (Spirit Level) 1115-1183
 Quadrangle Clarksburg
 County Harrison District Simpson
 Engineer W M Bowers
 Engineer's Registration No. 900
 File No. _____ Drawing No. _____
 Date 8-2-49 Scale 1" = 40 P

STATE OF WEST VIRGINIA
 DEPARTMENT OF MINES
 OIL AND GAS DIVISION
 CHARLESTON

WELL LOCATION MAP

FILE NO. HAR-1352-A # 5272
HAR-1373-A # 1404

+ Denotes location of well on United States Topographic Maps, scale 1 to 62,500, latitude and longitude lines being represented by border lines as shown.

- Denotes one inch spaces on border line of original tracing.



STATE OF WEST VIRGINIA
DEPARTMENT OF MINES
OIL AND GAS DIVISION

1198

Permit No. **1373-A**

WELL RECORD

Oil or Gas Well (KIND)


Company **Hope Natural Gas Company.**
Address **445 West Main St. Clarksburg, W. Va.**
Farm **L.E. Stout** Acres **130**
Location (waters) _____
Well No. **1404** Elev. **1115**
District **Simpson** County **Harrison**
The surface of tract is owned in fee by _____
Address _____
Mineral rights are owned by _____
Address _____

Drilling commenced **October 5, 1909**
Drilling completed **November 10, 1909**
Date Shot From _____ To _____
With _____
Open Flow /10ths Water in _____ Inch
/10ths Merc. in _____ Inch
Volume _____ Cu. Ft.
Rock Pressure _____ lbs. _____ hrs.
Oil _____ bbls., 1st 24 hrs.
Fresh water **none recorded** feet _____ feet
Salt water **none recorded** feet _____ feet

Casing and Tubing	Used in Drilling	Left in Well	Packers
Size			Kind of Packer
16			
13			
10	300	300	Size of
8 1/2	1250	1250	
6 1/2	1400	1400	Depth set
5 3/16			
3			Perf. top
2	2407	2407	Perf. bottom
Liners Used			Perf. top
			Perf. bottom

NOT
CASING CEMENTED _____ SIZE _____ No. Ft. _____ Date _____
Below
COAL WAS ENCOUNTERED AT _____ FEET _____ INCHES
_____ FEET _____ INCHES FEET _____ INCHES
_____ FEET _____ INCHES FEET _____ INCHES

Formation	Color	Hard or Soft	Top	Bottom	Oil, Gas or Water	Depth Found	Remarks
Little Dunkard			460	527			
Gas sand			548	660			
First Salt			710	790			
Maxon			1156	1192			
Little Linn			1285	1295			
Pencil cave			1295	1300			
Big Linn			1300	1380			
Big Injun			1380	1490	gas	1386	
Fifty foot			1802	1950	gas	1812	
Fifth			2348	2374	gas	2350	
Total depth				2407			

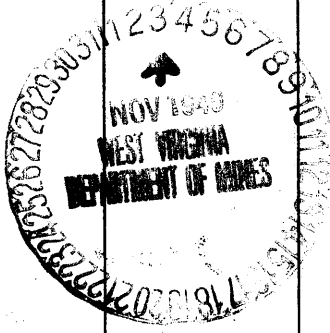

Formation	Color	Hard or Soft	Top	Bottom	Oil, Gas or Water	Depth Found	Remarks

Date November 2, 1949, 19____

APPROVED Hope Natural Gas Company, Owner

By _____

