


Latitude 39° 20'

Longitude 80° 20'

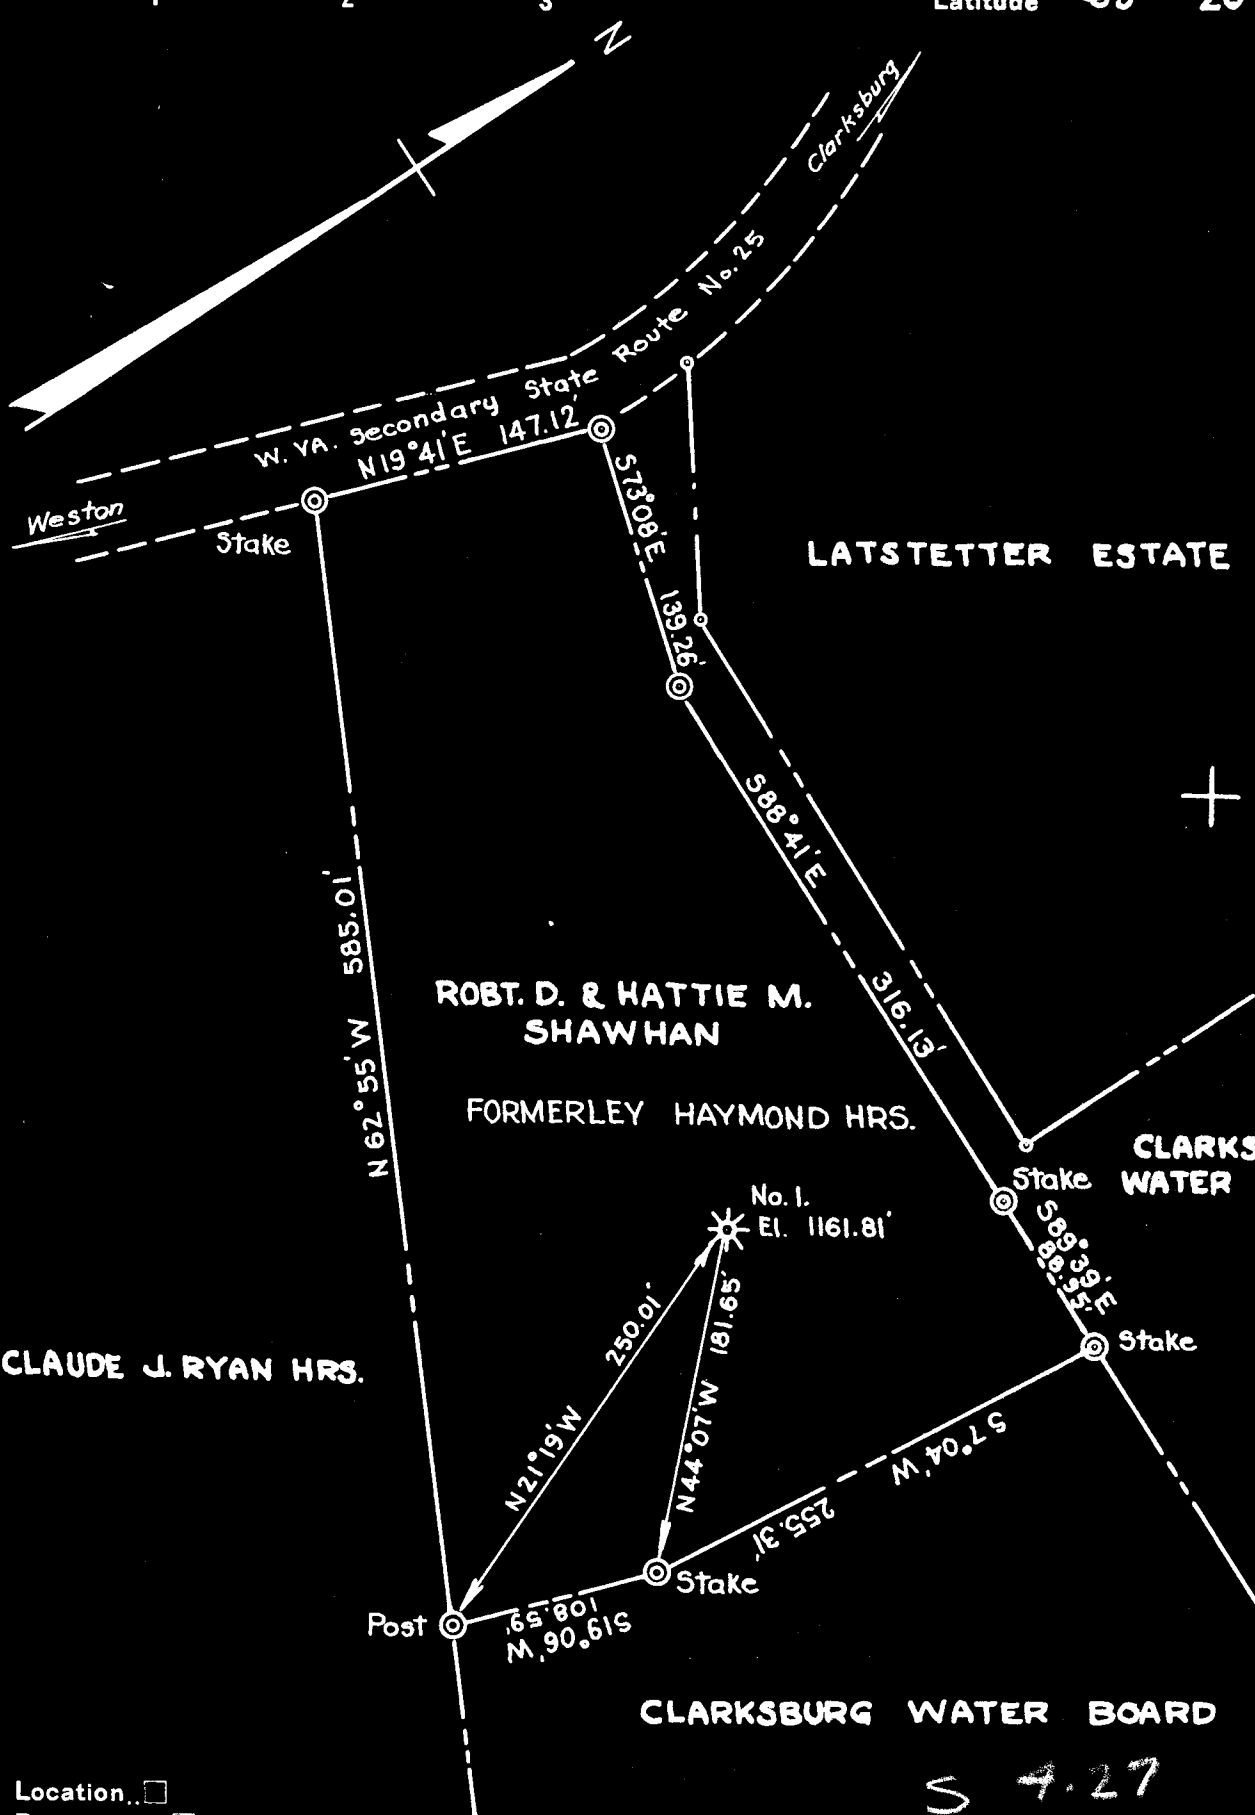

New Location...
 Drill Deeper...
 Abandonment...

S 4.27
 W 0.84

Company WASHINGTON GAS CO.
 Address CLARKSBURG, W. VA.
 Farm ROBT. D. & HATTIE M. SHAWHAN
 Tract _____ Acres 3.11 Lease No. _____
 Well (Farm) No. ONE Serial No. _____
 Elevation (Spirit Level) 1161.81'
 Quadrangle CLARKSBURG S W 4 3
 County HARRISON District CLARK
 Engineer PAUL ALLEN HORNOR
 Engineer's Registration No. 602
 File No. _____ Drawing No. _____
 Date NOV. 10, 1950 Scale 1" = 100'

STATE OF WEST VIRGINIA
 DEPARTMENT OF MINES
 OIL AND GAS DIVISION
 CHARLESTON

WELL LOCATION MAP
 FILE NO. HAR-1433-A

+ Denotes location of well on United States Topographic Maps, scale 1 to 62,500, latitude and longitude lines being represented by border lines as shown.

- Denotes one inch spaces on border line of original tracing.