

MAR 12 1952

4.66 S
3.50 W

3.55 W
4.72 A

Surface owned by Ford Brown.
Address: Mr. Ford Brown, R.F.D. No. 3, Salem, W. Va.
Coal owned by R.T. Lowndes Hrs.
Address: Mr. N.F. Raeder, P.O. Box No. 666, Clarksburg, W. Va.

MAR 28 1952

New Location...
Drill Deeper.....
Abandonment.....

On 800' Map N28. Sqs. 513-14E 3-4.

Company Raad Supply Co.
Address Salem, W. Va.
Farm R.T. Lowndes
Tract _____ Acres 447⁵⁷ Lease No. _____
Well (Farm) No. 12 Serial No. _____
Elevation (Spirit Level) Floor - 1172.54
Ground - 1170.79
Quadrangle Centerpoint
County Harrison District Ten Mile
Engineer Elsworth Haines
Engineer's Registration No. 2221
File No. _____ Drawing No. _____
Date Jan. 20th, 1951 Scale 1" = 800 Feet

STATE OF WEST VIRGINIA
DEPARTMENT OF MINES
OIL AND GAS DIVISION
CHARLESTON

WELL LOCATION MAP
FILE NO. HAR-1445-A

+ Denotes location of well on United States Topographic Maps, scale 1 to 62,500, latitude and longitude lines being represented by border lines as shown.
- Denotes one inch spaces on border line of original tracing.

IMPERIAL TRACING CLOTH
K & E CO., N. Y.

R. T. LOUNDES NO. 12 WELL.

Tennile District, Harrison County, W. Va. 1445A
By Road Supply Co., 184 E. Main St., Salem, W. Va.
Abandoned under permit Har-.....-A
On.....acres.

Elevation,' L.

Drilling commenced Jan. 24, 1906; completed March 13, 1906.

10" casing, 572' (pulled); 8 $\frac{1}{2}$ "⁸, 1418' (pulled); 6 $\frac{5}{8}$ "⁸, 2250'; 2" tubing, 2953'.

Casing not cemented.

Coal was encountered at 881-888'.

Oil well. Record to Dept. of Mines dated Jan. 8, 1951.

Record to RGT from Mrs. Griffith June 24, 1951. Old File No. 1258.

	Top.	Bottom.
Conductor	0	16
Pittsburgh Coal	881	888
Dunkard Sand	1418	1478
Big Lime	2244	2322
Big Injun Sand	2324	2404
Garden Sand	2935	2950
Total depth		2953



STATE OF WEST VIRGINIA
DEPARTMENT OF MINES
OIL AND GAS DIVISION

1258

WELL RECORD

Permit No. HAR-1445-A


Oil or Gas Well _____
(KIND)

Company Read Supply Company
 Address 184 East Main St., Salem, W. Va.
 Farm R. T. Loundes Acres _____
 Location (waters) _____
 Well No. 12 Elev. _____
 District San Hill County Harrison
 The surface of tract is owned in fee by _____
 Address _____
 Mineral rights are owned by _____
 Address _____
 Drilling commenced XXXXXXXXX Jan. 24, 1906
 Drilling completed XXXXXXXXX March 13, 1906
 Date Shot _____ From _____ To _____
 With _____
 Open Flow _____ /10ths Water in _____ Inch
 _____ /10ths Merc. in _____ Inch
 Volume _____ Cu. Ft.
 Rock Pressure _____ lbs. _____ hrs.
 Oil _____ bbls., 1st 24 hrs.
 Fresh water _____ feet _____ feet
 Salt water _____ feet _____ feet

Casing and Tubing	Used in Drilling	Left in Well	Packers
Size			
16			Kind of Packer _____
18			
10	572'	None	Size of _____
8 1/4	1418'	None	
6 3/8	2250'	2250'	Depth set _____
5 3/16			
3			Perf. top _____
2	2953'	2953'	Perf. bottom _____
Liners Used			Perf. top _____
			Perf. bottom _____

CASING CEMENTED **No** SIZE _____ No. Ft. _____ Date _____
 COAL WAS ENCOUNTERED AT ⁵⁸¹⁻ **898** FEET **84** INCHES
 _____ FEET _____ INCHES FEET _____ INCHES
 _____ FEET _____ INCHES FEET _____ INCHES

Formation	Color	Hard or Soft	Top	Bottom	Oil, Gas or Water	Depth Found	Remarks
Conductor				16			
Pittsburgh Coal			881	888			
Dunkard Sand			1418	1478			
Big Lime			2244	2322			
Big Injun Sand			2324	2404			
Gordon Sand			2935	2950			
Total Depth				2955			

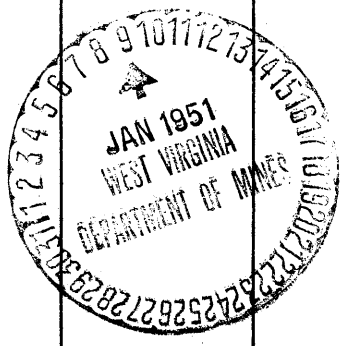

JUN 24 1951

