

New Location   
 Drill Deeper   
 Abandonment  (6988)

Company Hope Natural Gas Co.  
 Address Clarksburg, W.Va.  
 Farm M. R. Lodge  
 Tract \_\_\_\_\_ Acres 602 Lease No. 42741  
 Well (Farm) No. 6, 2, 3 and 4 Serial No. 6985-6988  
 Elevation (Spirit Level) 1045-1141-1003-1098  
 Quadrangle Clarksburg  
 County Harrison District Simpson  
 Engineer Wm Powers  
 Engineer's Registration No. 900  
 File No. \_\_\_\_\_ Drawing No. \_\_\_\_\_  
 Date June 4, 1941 Scale 1" = 80'

STATE OF WEST VIRGINIA  
 DEPARTMENT OF MINES  
 OIL AND GAS DIVISION  
 CHARLESTON

WELL LOCATION MAP  
 FILE NO. HAR-653A  
6988  
HAR-1452-A-#6777

+ Denotes location of well on United States Topographic Maps, scale 1 to 62,500, latitude and longitude lines being represented by border lines as shown.  
 - Denotes one inch spaces on border line of original tracing.

M. R. LODGE NO. 6907 WELL.

1452A

Stapson District, Harrison County, W. Va.  
 By Hope Natural Gas Co., 445 W. Main St., Clarksburg, W. Va.

Abandoned under permit No.-----AT

On 602 acres.

Elevation, 970' l.

Drilling completed Aug. 8, 1924.

Purchased well.

Fresh water, 530'.

Salt water, none recorded.

10" casing, 155'; 8", 815'; 6", 1304'; 2" tubing, 2364' (pulled).

Casing not cemented.

Starts below coal.

Gas well. Record to Dept. of Mines dated Feb. 26, 1951.

Record to RCT from Mrs. Griffith June 28, 1951. Old File No. 1266.

	Top.	Bottom.
Little Dunkard Sand	340	- 375
Big Dunkard Sand	435	- 460
First Salt Sand (NW, 530')	510	- 580
Second Salt Sand	595	- 635
Third Salt Sand	655	- 860
Maxton Sand	1145	- 1177
Little Lime	1225	- 1237
Pencil Cove	1237	- 1252
Big Lime	1252	- 1335
Big Injun Sand	1335	- 1415
Sugar Sand	1425	- 1458
Fifty-foot Sand	1795	- 1894
Thirty-foot Sand	1895	- 1990
Garden Stray Sand	2160	- 2174
Garden Sand	2182	- 2210
Fourth Sand	2236	- 2249
Fifth Sand (gas, 2335')	2306	- 2347
Total depth		2364



1166

STATE OF WEST VIRGINIA  
DEPARTMENT OF MINES  
OIL AND GAS DIVISION

WELL RECORD

Permit No. HAR-1452-A


~~Oil~~ or Gas Well \_\_\_\_\_  
(KIND)

Company Hope Natural Gas Company.  
 Address 445 West Main St. Clarksburg, W. Va.  
 Farm M.R. Lodge Acres 602  
 Location (waters) \_\_\_\_\_  
 Well No. 6987 Elev. 970  
 District Simpson County Harrison  
 The surface of tract is owned in fee by \_\_\_\_\_  
 Address \_\_\_\_\_  
 Mineral rights are owned by \_\_\_\_\_  
 Address \_\_\_\_\_  
 Drilling commenced \_\_\_\_\_  
 Drilling completed Aug. 8, 1924  
 Date Shot \_\_\_\_\_ From \_\_\_\_\_ To \_\_\_\_\_  
 With \_\_\_\_\_  
 Open Flow \_\_\_\_\_ /10ths Water in \_\_\_\_\_ Inch  
 \_\_\_\_\_ /10ths Merc. in \_\_\_\_\_ Inch  
 Volume purchased \_\_\_\_\_ Cu. Ft.  
 Rock Pressure \_\_\_\_\_ lbs. \_\_\_\_\_ hrs.  
 Oil \_\_\_\_\_ bbls., 1st 24 hrs.  
 Fresh water 530 feet \_\_\_\_\_ feet  
 Salt water None recorded feet \_\_\_\_\_ feet

Casing and Tubing	Used in Drilling	Left in Well	Packers
Size			
16			Kind of Packer
13			
10	155	155	Size of
8 1/4	815	815	
6 3/4	1324	1324	Depth set
5 3/16			
3			Perf. top
2	2364	Pulled	Perf. bottom
Liners Used			Perf. top
			Perf. bottom
		Not	

CASING CEMENTED \_\_\_\_\_ SIZE \_\_\_\_\_ No. Ft. \_\_\_\_\_ Date \_\_\_\_\_  
 \_\_\_\_\_ Below \_\_\_\_\_  
 COAL WAS ENCOUNTERED AT \_\_\_\_\_ FEET \_\_\_\_\_ INCHES  
 \_\_\_\_\_ FEET \_\_\_\_\_ INCHES FEET \_\_\_\_\_ INCHES  
 \_\_\_\_\_ FEET \_\_\_\_\_ INCHES FEET \_\_\_\_\_ INCHES

Formation	Color	Hard or Soft	Top	Bottom	Oil, Gas or Water	Depth Found	Remarks
Little Dunkard			340	375			
Big Dunkard			435	460			
First Salt			510	580	hole full water	530	
Second Salt			595	635			
Third Salt			655	860			
Maxon			1145	1177			
Little Lime			1225	1237			
Pencil cave			1237	1252			
Big Lime			1252	1335			
Big Injun			1335	1415			
Squaw			1425	1458			
Fifty foot			1795	1894			
Thirty foot			1895	1990			
Gordon stray			2160	2174			
Gordon			2182	2210			
Fourth			2236	2249			
Fifth			2306	2347	gas	2335	
Total depth				2364			

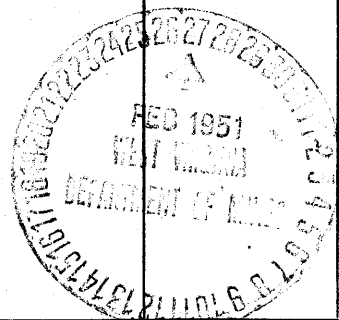

JUN 28 1951

Color	Hard or Soft	Top	Bottom	Oil, Gas or Water	Depth Found	Remarks

Date **February 26, 1951**, 19

APPROVED **Hope Natural Gas Company.**, Owner

By \_\_\_\_\_

(Title)  
*[Handwritten Signature]*