

0.47S
0.62W
0.62W
0.48A

Surface & Coal owned by Alex Riley Hrs.
Address: Mr. Will E. Morris, P.O. Box No. 442. Clarksburg, W. Va.

New Location
Drill Deeper
Abandonment

MAR 12 1952
MAR 28 1952

On 800 Map N29. Sqs. 59 E 6.

Company Road Supply Co.
Address Salem, W. Va.
Farm Alex Riley
Tract _____ Acres 29 Lease No. _____
Well (Farm) No. 2 Serial No. _____
Elevation (Spirit Level) Floor -- 1184.79
Ground - 1183.79
Quadrangle Centerpoint
County Harrison District Ten Mile
Engineer Eleworth Haines
Engineer's Registration No. 2221
File No. _____ Drawing No. _____
Date Nov. 13th, 1950 Scale 1" = 400 Feet.

STATE OF WEST VIRGINIA
DEPARTMENT OF MINES
OIL AND GAS DIVISION
CHARLESTON

WELL LOCATION MAP
FILE NO. HAR-1456-A

+ Denotes location of well on United States Topographic Maps, scale 1 to 62,500, latitude and longitude lines being represented by border lines as shown.

- Denotes one inch spaces on border line of original tracing.

ALEX RILEY NO. 2 WELL.

1456-A

Tennile District, Harrison County, W. Va.

By Raad Supply Co., 184 E. Main St., Salem, W. Va.

Abandoned under permit Har-.....-A1

On 29 acres, on Collins Run.

Elevation, 1183.79' L.

Surface and minerals owned by Will B. Morris, Box 442, Clarksburg, W. Va.

Drilling commenced July 14, 1902; completed Aug. 31, 1902.

6" casing, 2253'; 2" tubing, 2947'; all left in.

Casing not cemented.

Coal was encountered at 860-867'.

Oil well. Record to Dept. of Mines dated Nov. 24, 1951.

Record to RCT from Mrs. Griffith June 28, 1951. Old File No. 1267.

	Top.	Bottom.
Pittsburgh Coal	860	- 867
Big Dunkard Sand	1360	- 1430
Big Injun Sand	2260	- 2360
Garden Sand	2928	- 2947
Total depth		2947



STATE OF WEST VIRGINIA
DEPARTMENT OF MINES
OIL AND GAS DIVISION

1767

WELL RECORD

Permit No. HAR-7456-A


Oil or Gas Well _____
(KIND)

Company Read Supply Company
 Address 184 East Main St., Salem, W. Va.
 Farm Alex Riley Acres 29
 Location (waters) Collins Run
 Well No. 2 Elev. 1183.79
 District Ten Mile County Harrison
 The surface of tract is owned in fee by Will E. Morris
Box 442 Address Clarksburg, W. Va.
 Mineral rights are owned by Will E. Morris
Box 442 Address Clarksburg, W. Va.
 Drilling commenced July 14, 1902
 Drilling completed August 31, 1902
 Date Shot _____ From _____ To _____
 With _____
 Open Flow _____ /10ths Water in _____ Inch
 _____ /10ths Merc. in _____ Inch
 Volume _____ Cu. Ft.
 Rock Pressure _____ lbs. _____ hrs.
 Oil _____ bbls., 1st 24 hrs.
 Fresh water _____ feet _____ feet
 Salt water _____ feet _____ feet

Casing and Tubing	Used in Drilling	Left in Well	Packers
Size			
16			Kind of Packer
18			
10			Size of
8 1/4			
6 1/2	2258'	2258'	Depth set
5 3/16			
3			Perf. top
2	2947'	2947'	Perf. bottom
Liners Used			Perf. top
			Perf. bottom

CASING CEMENTED No SIZE _____ No. Ft. _____ Date _____
 COAL WAS ENCOUNTERED AT 867 FEET 84 INCHES
 _____ FEET _____ INCHES FEET _____ INCHES
 _____ FEET _____ INCHES FEET _____ INCHES

Formation	Color	Hard or Soft	Top	Bottom	Oil, Gas or Water	Depth Found	Remarks
Pittsburgh Coal			860'	867'			
Big Dunkard Sand			1360	1430			
Big Injun Sand			2260	2360			
Gordon Sand			2928	2947			
Total Depth				2947			

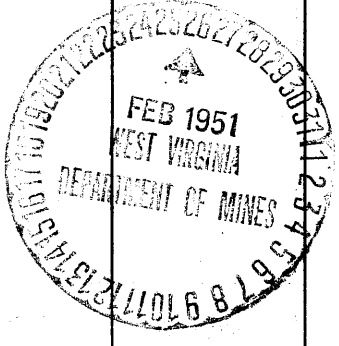

(Over) JUN 28 1951

Formation	Color	Hard or Soft	Top	Bottom	Oil, Gas or Water	Depth Found	Remarks

Date Feb 24, 1951
APPROVED Reed Supply Co., Owner
By Jm. Reed Myrner
(Title)