

Surface owned by James L. Smith.
 Address: Mr. James L. Smith, R.F.D. No. 1, Bristol, W. Va.
 Coal owned by Willis G. Tetrick, Jr.
 Address: Mr. Willis G. Tetrick, Jr. P.O. Box No. 267, Clarksburg, W. Va.

New Location
 Drill Deeper
 Abandonment

MAR 12 1952 MAR 28 1952
 On 800' Map N29, Sqs. 9 10-11 E 8-9.

Company Road Supply Co.
 Address Salem, W. Va.
 Farm J. C. Smith
 Tract _____ Acres 60 Lease No. _____
 Well (Farm) No. 1, 2 & 5 Serial No. _____
 Elevation (Spirit Level) See Wells above for Elev
 Quadrangle Clarksburg
 County Harrison District Ten Mile
 Engineer Elworth Haines
 Engineer's Registration No. 2221
 File No. _____ Drawing No. _____
 Date Sept. 28th, 1950 Scale 1" = 400 Feet

STATE OF WEST VIRGINIA
 DEPARTMENT OF MINES
 OIL AND GAS DIVISION
 CHARLESTON

WELL LOCATION MAP

FILE NO. HAR-1457-A-#5
 HAR-1458-A-#2

+ Denotes location of well on United States Topographic Maps, scale 1 to 62,500, latitude and longitude lines being represented by border lines as shown.
 - Denotes one inch spaces on border line of original tracing.

J. S. SMITH NO. 5 WELL.

1457A

Tennile District, Harrison County, W. Va.

By Read Supply Co., 184 E. Main St., Salem, W. Va.

Abandoned under permit Har-.....-A1

On 60 acres, on fork of New Creek.

Elevation, 1368.73' L.

Surface owned by E. L. Smith, R. F. D. No. 1, Bristol, W. Va., and
minerals by Willis G. Patrick, Jr., Box 267, Clarksburg, W. Va.

Drilling commenced Feb. 5, 1900; completed March 27, 1900.

6" casing, 1907'; 2" tubing, 2900'; all left in; 5 1/2" liner, 400'.

Casing not cemented.

Coal was encountered at 522-529'.

Oil well. Record to Dept. of Mines dated Feb. 23, 1951.

Record to RCT from Mrs. Griffith June 28, 1951. Old File No. 1268.

	Top.	Bottom.
Pittsburgh Coal	522	- 529
Big Dunkard Sand	1009	- 1051
Big Injun Sand	1925	- 2030
Garden Sand	2600	- 2620
Total depth		2900



STATE OF WEST VIRGINIA
DEPARTMENT OF MINES
OIL AND GAS DIVISION

1968

Handwritten signature

WELL RECORD

Permit No. HAR-1457-A


Oil or Gas Well _____ (KIND)

Company Read Supply Company
Address 184 East Main St., Salem, W. Va.
Farm J. S. Smith Acres 60
Location (waters) Fk. of New Creek
Well No. 5 Elev. 1368.73
District Ten Mile County Harrison
The surface of tract is owned in fee by Mr. J. L. Smith
R. F. D. #1 Address Bristol, W. Va.
Mineral rights are owned by Mr. Willis C. Tetrick, Jr.
Box 267 Address Clarkeburg, W. Va.
Drilling commenced February 5, 1900
Drilling completed March 27, 1900
Date Shot _____ From _____ To _____
With _____
Open Flow _____ /10ths Water in _____ Inch
_____ /10ths Merc. in _____ Inch
Volume _____ Cu. Ft.
Rock Pressure _____ lbs. _____ hrs.
Oil _____ bbls., 1st 24 hrs.
Fresh water _____ feet _____ feet
Salt water _____ feet _____ feet

Casing and Tubing	Used in Drilling	Left in Well	Packers
Size			
16			Kind of Packer
13			
10			Size of
8 1/2			
6	1907'	1907'	Depth set
5 3/16			
3			Perf. top
2	2900'	2900'	Perf. bottom
Liners Used			Perf. top
5-3/16"	400'	400'	Perf. bottom

CASING CEMENTED **No** SIZE _____ No. Ft. _____ Date _____
COAL WAS ENCOUNTERED AT **529** FEET **84** INCHES
_____ FEET _____ INCHES FEET _____ INCHES
_____ FEET _____ INCHES FEET _____ INCHES

Formation	Color	Hard or Soft	Top	Bottom	Oil, Gas or Water	Depth Found	Remarks
Pittsburgh Coal			522	529			
Big Dunkard Sand			1009	1051			
Big Injun Sand			1925	2030			
Gordon Sand			2600	2620			
Total Depth				2900			

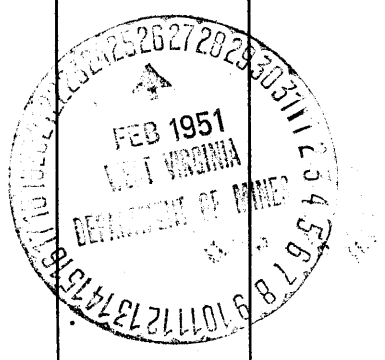

JUN 28 1951

Formation	Color	Hard or Soft	Top	Bottom	Oil, Gas or Water	Depth Found	Remarks

Date Feb 23, 1951
APPROVED Road Supply Co, Owner
By Jm. Road, My owner
(Title)