

Company Hope Natural Gas Co

Address Clarksburg, W.Va.

Farm W.J. Ashcraft

Tract _____ Acres 33 Lease No. 61837

Well (Farm) No. _____ Serial No. 9534

Elevation (Spirit Level) 1127'

Quadrangle Clarksburg NC

County Harrison District Eagle

Engineer W.M. Bowers

Engineer's Registration No. 900

File No. _____ Drawing No. _____

Date 3-23-51 Scale 1" = 20 P

STATE OF WEST VIRGINIA
DEPARTMENT OF MINES
OIL AND GAS DIVISION
CHARLESTON

WELL LOCATION MAP
FILE NO. HAR-1460-A

+ Denotes location of well on United States Topographic Maps, scale 1 to 62,500, latitude and longitude lines being represented by border lines as shown.

- Denotes one inch spaces on border line of original tracing.

W. J. ASHCRAFT NO. 9534 (MR-904) (POCCO-1049) WELL.

1460A

Eagle District, Harrison County, W. Va.

By Hope Natural Gas Co., 445 W. Main St., Clarksburg, W. Va.

Abandoned under permit HAF-.....-A1

On 33 acres.

Elevation, 1127' L.

No record of date of completion, etc.

10" casing, 215'; no casing record. Believe cemented.

Coal was encountered at 195-203'.

Gas well. Record to Dept. of Mines dated April 5, 1951.

Record to RGT from Mrs. Griffith Aug. 17, 1951. Old File No. 1269.

	Top.	Bottom.	
Pittsburgh Coal	195	- 203	
Salt Sand	1000	- 1680	Est.
Big Lime	1525	- 1595	Est.
Big Injan Sand	1595	- 1685	Est.
Gantz Sand	2005	- 2020	Est.
Fifty-foot Sand	2125	- 2235	Est.
Cardon Sand	2410	- 2444	Est.
Fifth Sand (gas)	2575	- 2580	

"No record of this well; possibly gas in Gantz and Fifty-foot."



STATE OF WEST VIRGINIA
DEPARTMENT OF MINES
OIL AND GAS DIVISION

1269

WELL RECORD

Permit No. HAR-1460A

Oil or Gas Well
(KIND)

Company Hope Natural Gas Company.
 Address 445 West Main St. Clarksburg, W. Va.
 Farm W. J. Ashcraft Acres 33
 Location (waters) _____
 Well No. 9534 MP 90 PCCGO 1049 Elev. 1127
 District Eagle County Harrison
 The surface of tract is owned in fee by _____
 Address _____
 Mineral rights are owned by _____
 Address _____
 Drilling commenced no record
 Drilling completed _____
 Date Shot _____ From _____ To _____
 With _____
 Open Flow /10ths Water in _____ Inch
 /10ths Merc. in _____ Inch
 Volume _____ Cu. Ft.
 Rock Pressure _____ lbs. _____ hrs.
 Oil _____ bbls., 1st 24 hrs.
 Fresh water no record feet _____ feet
 Salt water _____ feet _____ feet


Casing and Tubing	Used in Drilling	Left in Well	Packers
Size			Kind of Packer
16			
13			
10	216	216	Size of
8 1/4			
6 5/8	no casing record		Depth set
5 3/16			
3			Perf. top
2			Perf. bottom
Liners Used			Perf. top
			Perf. bottom

Believe cemented
CASING CEMENTED _____ SIZE _____ No. Ft. _____ Date _____

COAL WAS ENCOUNTERED AT 195 FEET 96 INCHES
 _____ FEET _____ INCHES FEET _____ INCHES
 _____ FEET _____ INCHES FEET _____ INCHES

Formation	Color	Hard or Soft	Top	Bottom	Oil, Gas or Water	Depth Found	Remarks
Pittsburgh Coal			195	203			
Salt sand			1000	1680 Est			
Big Lime			1525	1595 Est			
Big Injun			1595	1685 Est.			
Gants			2005	2020 Est			
Fifty foot			2125	2235 Est			
Gordon			2410	2444 Est			
Fifth			2575	2580 Est	Gas	??	

No record of this well, possible gas in Gants and Fifty foot.

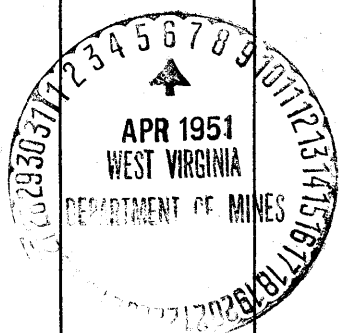

Formation	Color	Hard or Soft	Top	Bottom	Oil, Gas or Water	Depth Found	Remarks

Date April 5, 1951., 19

APPROVED Hope Natural Gas Company., Owner

By _____

(Title)
