

Company **VALLEY STEEL PRODUCTS CO.**

Address **St. Louis, Mo.**

Farm **W. Brent Maxwell**

Tract _____ Acres **1300** Lease No. _____

Well (Farm) No. **14, 22, 33, 38** Serial No. _____

Elevation (Spirit Level) **No. 14: 1030, No. 22: 1134, No. 33: 1095**

Quadrangle **Weston**

County **Harrison** District **Union**

Engineer **[Signature]**

Engineer's Registration No. **1227**

File No. _____ Drawing No. _____

Date **October, 1951** Scale **1" = 500'**

STATE OF WEST VIRGINIA
DEPARTMENT OF MINES
OIL AND GAS DIVISION
CHARLESTON

WELL LOCATION MAP

FILE NO. **HAR-1507-A-#14**
HAR-1508-A-#22
HAR-1510-A-#33
HAR-1512-A-#38

+ Denotes location of well on United States Topographic Maps, scale 1 to 62,500, latitude and longitude lines being represented by border lines as shown.

- Denotes one inch spaces on border line of original tracing.



STATE OF WEST VIRGINIA
DEPARTMENT OF MINES
OIL AND GAS DIVISION

1401

WELL RECORD

Permit No. HAR-1508-A


Oil or Gas Well X (KIND)

Company Valley Steel Products Co.
Address St. Louis, Mo.
Farm W. Brent Maxwell Acres 1300
Location (waters) West Fork River
Well No. 22 Elev. 1134
District Union County Harrison
The surface of tract is owned in fee by Frank Maxwell
Address Clarksburg, W. Va.
Mineral rights are owned by _____
Address _____
Drilling commenced _____
Drilling completed 6/7/14
Date Shot _____ From _____ To _____
With _____
Open Flow _____ /10ths Water in _____ Inch
_____ /10ths Merc. in _____ Inch
Volume _____ Cu. Ft.
Rock Pressure _____ lbs. _____ hrs.
Oil _____ bbls., 1st 24 hrs.
Fresh water _____ feet _____ feet
Salt water _____ feet _____ feet

Casing and Tubing	Used in Drilling	Left in Well	Packers
Size			
16			Kind of Packer
13			
10			Size of
8 1/2			
6%	1474	1474	Depth set
5 3/16			
3			Perf. top
2	2303	2303	Perf. bottom
Liners Used			Perf. top
			Perf. bottom

CASING CEMENTED _____ SIZE _____ No. Ft. _____ Date _____
COAL WAS ENCOUNTERED AT _____ FEET _____ INCHES
_____ FEET _____ INCHES FEET _____ INCHES
_____ FEET _____ INCHES FEET _____ INCHES

Formation	Color	Hard or Soft	Top	Bottom	Oil, Gas or Water	Depth Found	Remarks
Pittsburgh Coal							
Little Dunkard							
Big Dunkard			505	548			
Gas Sand			680	695			
First Salt			835	900			
Second Salt			945	1010			
Maxon			1375	1405			
Little Line			1420	1435			
Pencil Cave			1455	1445			
Big Line			1445	1525			
Big Injun			1525	1615			
Squaw							
Berea							
Gants							
Fifty Foot			2040	2100			
Thirty Foot			2105	2150			
Gordon Stray			2205	2225			
Jordon			2284	2286			
Oil			2290	2294			
Fourth							
Fifth							
Speechly							
Total Depth				2303			

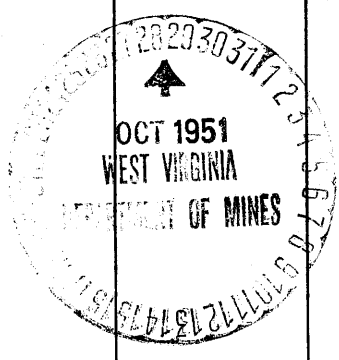

(Over)

JUL 9 1952