

LATITUDE 39° 17' 30"

LONGITUDE 80° 32' 30"



1.79a

1.42w

7'5 OGIS topo location

7.5' loc _____

15' loc _____
(calc.) _____

Company Road Supply Co.

Farm R.T. Lowndes #13

Quad Salem 7 1/2

County Harrison

District Tenmile (a)

WELL LOCATION MAP

File No. 033 - 31552

R. T. LOWMEDES NO. 13 WELL.

1552A

Tennile District, Harrison County, W. Va.
By Road Supply Co., 184 E. Main St., Salem, W. Va.
Abandoned under permit Har-.....-A?
On 447.57 acres, on Patterson Park.
Elevation, 1217.81' L.

Surface owned by Ford Brown, R. F. D. No. 1, Salem, W. Va., and
minerals by R. T. Lowmedes Heirs, N. F. Reeder, Box 666,
Clarksburg, W. Va.

Drilling commenced Aug. 14, 1907; completed Sept. 25, 1907.
6 $\frac{1}{2}$ " casing, 2408'; 2" tubing, 3020'; all left in.
Casing not cemented.

Coal was encountered at 936-943'.

Oil well. Record to Dept. of Mines dated June 11, 1952.

Record to RCT from Mrs. Griffith Dec. 10, 1952. O.F.No.1431.

	Top.	Bottom.
Pittsburgh Coal	936	- 943
Big Dunkard Sand	1348	- 1403
Big Lime	2189	- 2222
Big Injun Sand	2230	- 2284
Fifty-foot Sand	2864	- 2903
Stray Sand	2955	- 2976
Gordon Sand	2995	- 3015
Total depth		3020



STATE OF WEST VIRGINIA
DEPARTMENT OF MINES
OIL AND GAS DIVISION

1421

WELL RECORD

Permit No. NAOR-1552-A

Oil or Gas Well _____ (KIND)


Company Read Supply Company
Address 184 East Main St., Salem, W. Va.
Farm R. T. Lowndes Acres 447.57
Location (waters) Patterson Fork
Well No. 15 Elev. 1217.81
District Ten Mile County Harrison
The surface of tract is owned in fee by Ford Brown
R. F. D. #1 Address Salem, W. Va.
Mineral rights are owned by R. T. Lowndes Hrs.
Address H. F. Raeder, Box 666-Clarksburg W. Va.
Drilling commenced Aug. 14, 1907
Drilling completed September 25, 1907
Date Shot _____ From _____ To _____
With _____

Casing and Tubing	Used in Drilling	Left in Well	Packers
Size			
16			Kind of Packer
13			
10			Size of
8 1/4			
6 3/8	2408'	2408'	Depth set
5 3/16			
3			Perf. top
2	3020'	3020'	Perf. bottom
Liners Used			Perf. top
			Perf. bottom

Open Flow _____ /10ths Water in _____ Inch
_____ /10ths Merc. in _____ Inch
Volume _____ Cu. Ft.
Rock Pressure _____ lbs. _____ hrs.
Oil _____ bbls., 1st 24 hrs.
Fresh water _____ feet _____ feet
Salt water _____ feet _____ feet

CASING CEMENTED No SIZE _____ No. Ft. _____ Date _____
COAL WAS ENCOUNTERED AT 956 FEET 94 INCHES
_____ FEET _____ INCHES FEET _____ INCHES
_____ FEET _____ INCHES FEET _____ INCHES

Formation	Color	Hard or Soft	Top	Bottom	Oil, Gas or Water	Depth Found	Remarks
Pittsburgh Coal			956	945			
Big Dunkard Sand			1548	1403			
Big Lime			2189	2222			
Big Injun			2250	2284			
Fifty Foot Sand			2864	2908			
Stray Sand			2955	2976			
Gordon Sand			2995	3015			
Total Depth				3020			

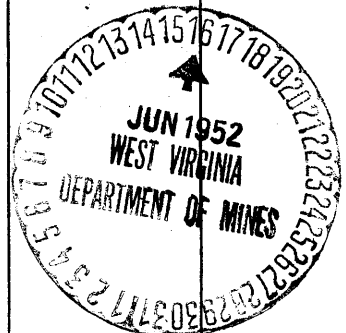

Formation	Color	Hard or Soft	Top	Bottom	Oil, Gas or Water	Depth Found	Remarks

Date June 11, 1952

APPROVED Paul Supply Co. Owner

By Jm. Rood, Jr. owner
(Title)



Section under by Cold Spring
 under the Cold Spring, N. 20 W. 1/4 Sec. 10, T. 10 N., R. 10 W.
 East half of 1/4 Sec. 10, T. 10 N., R. 10 W.
 Section, N. 20 W. 1/4 Sec. 10, T. 10 N., R. 10 W.

This map
 was made
 by
 J. H. [Name]
 [Address]
 [City, State]

STATE OF WEST VIRGINIA
 DEPARTMENT OF LAND
 AND GAS DIVISION
 CHARLESTON
 1914