

Latitude 39° 25'


2730

2750
0160

JOHN T FOX

Longitude 80° 20'

Scale 1 = 100 Feet

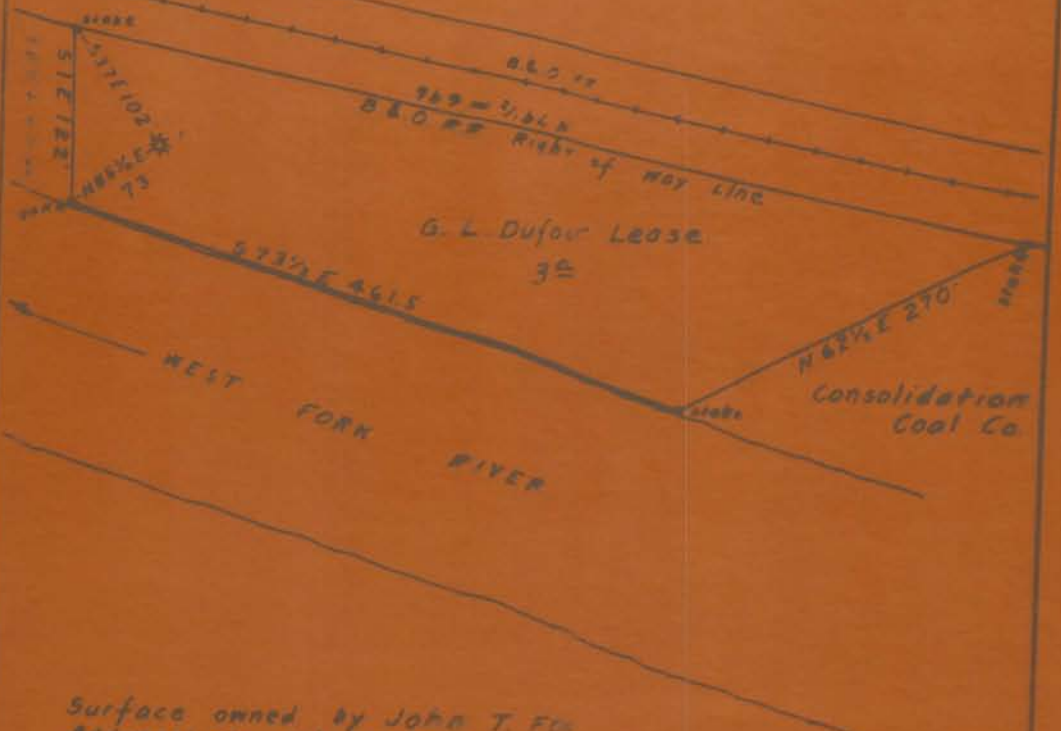

Surface owned by John T. Fox
Address: Mr. John T. Fox, Haywood, W. Va.
No Coal

New Location
On Deeper
Soundment

073-31556
* On 800 Map N 31 E S 1 S 6 E 16

William Moxel



STATE OF WEST VIRGINIA
DEPARTMENT OF MINES
OIL AND GAS DIVISION

033-31556

WELL RECORD

Permit No. 16

Oil or Gas Well (oil)

Company H. K. Koser
Address Salem, W. Va.
Farm J. L. Dufour Acres _____
Location (state) _____
Well No. 006 Elev. _____
District Eagle County Harrison
The surface tract owned in fee by _____
Address _____
Mineral rights are owned by _____
Address _____
Drilling commenced _____
Drilling completed 9/14/17
Casing Shot From _____ To _____
Well _____
Open Flow 100 lbs Water in _____ Inch
0 lbs Gas in _____ Inch
Viscosity _____ Ck. Pt. _____
Skin Friction _____ lbs _____
Oil _____ lbs. at 24 hrs. _____
Produced water _____ feet _____
Salt water _____ feet _____

Casing or Tubing	Used in Drilling	Left in Well	Packers
Size			
16			Kind of Packers
18			
12			Size of
2 1/2			
2 1/2		2000	Depth set
2			Part top
2		2165	Part bottom
Lower 1/2			Part top
			Part bottom

CASING OR CEMENT	SIZE	No. Ft.	Date
COAL UNWASCONVERTED AT	FEET	INCHES	
	FEET	INCHES	
	FEET	INCHES	

Stratigraphic	Color	Hard or Soft	Top	Bottom	Oil, Gas or Water	Depth Found	Remarks
Dunard			275	2665			
Maxx			965	20980			
L. Loe			1139	22154			
B. Loe			1159	22225			
Injn			1215	22320			
Goron			1907	22666			
SOt			2130	22145			
Total Depth				22465			