

Company HAL PACK & CO.
 Address HAMLIN, W. VA.
 Farm S. C. STUTLER
 Tract _____ Acres 42 Lease No. _____
 Well (Farm) No. 2 Serial No. _____
 Elevation (Spirit Level) 1015
 Quadrangle WESTON
 County HARRISON District UNION
 Engineer PAUL E. JOACHIM
 Engineer's Registration No. 669
 File No. _____ Drawing No. _____
 Date NOVEMBER 24, 1953 Scale 1" = 400'

STATE OF WEST VIRGINIA
 DEPARTMENT OF MINES
 OIL AND GAS DIVISION
 CHARLESTON

WELL LOCATION MAP
 FILE NO. HAR-1603-A

+ Denotes location of well on United States Topographic Maps, scale 1 to 62,500, latitude and longitude lines being represented by border lines as shown.

- Denotes one inch spaces on border line of original tracing.



STATE OF WEST VIRGINIA
DEPARTMENT OF MINES
OIL AND GAS DIVISION

1483

Quadrangle _____
Permit No. 1603-A

WELL RECORD

Oil or Gas Well _____ (KIND)


Company HAL H. PACK
Address HAMLIN, WEST VIRGINIA
Farm S. C. STUTLER Acres YV
Location (waters) _____
Well No. 1 Elev. 1015
District UNION County HARRISON
The surface of tract is owned in fee by _____
Address _____
Mineral rights are owned by _____
Address _____
Drilling commenced UNKNOWN
Drilling completed UNKNOWN
Date Shot _____ From _____ To _____
With _____
Open Flow _____ /10ths Water in _____ Inch
_____ /10ths Merc. in _____ Inch
Volume _____ Cu. Ft.
Rock Pressure _____ lbs. _____ hrs.
Oil _____ bbls., 1st 24 hrs.
Fresh water _____ feet _____ feet
Salt water _____ feet _____ feet

Casing and Tubing	Used in Drilling	Left in Well	Packers
Size			
16			Kind of Packer <u>B.H.</u>
13			<u>8-1/4" x 6-5/8"</u>
10			Size of <u>B.H.</u>
8 1/4	<u>654'</u>	<u>654'</u>	<u>6-5/8" x 5-3/16"</u>
6 5/8	<u>1491'</u>	<u>1491'</u>	Depth set _____
5 3/16	<u>2170'</u>	<u>2170'</u>	
3			Perf. top _____
2			Perf. bottom _____
Liners Used			Perf. top _____
			Perf. bottom _____

CASING CEMENTED _____ SIZE _____ No. Ft. _____ Date _____
COAL WAS ENCOUNTERED AT _____ FEET _____ INCHES
_____ FEET _____ INCHES FEET _____ INCHES
_____ FEET _____ INCHES FEET _____ INCHES

Formation	Color	Hard or Soft	Top	Bottom	Oil, Gas or Water	Depth Found	Remarks
Little Dunkard			350	375			
Coal			422	425			
Big Dunkard			470	570			
Gas Sand			615	630			
1st Salt Sand			825	875			
2nd Salt Sand			890	990			
Naxon			1025	1050			
Little Line			1400	1415			
Pencil Cave			1415	1430			
Big Line			1430	1490			
Big Injun			1490	1530			
Squaw			1540	1560			
Gants			1610	1630			
Berea			1710	1730			
Fifty-Foot			1810	1850			
Thirty-Foot			1960	1980			
Gordon Stray			2102				
Speckley			3000	3031			
Total Depth				3036			

Handwritten initials and a checkmark.

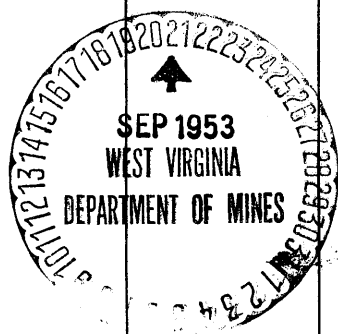

(Over) JAN 2 1954
JAN 2 REC'D