

Latitude 39° 25'

Boyd Hornor

Buel McIntyre

Joseph McIntyre

ALLEY

N 84 1/4 W 120'

stake

stake

Longitude 80° 20'

Bessie Vincent

F. W. Cunningham Lease
1/3_a

James Shaffer

S 53 1/4 W 120'

N 53 1/4 E 120'

Well No. 1.

stake

N 49 E 29'

S 72 1/2 E 102'

S 84 1/4 E 120'

stake

MAIN STREET

Charles Miller

Joseph Tina

Rosco Hawkins

2.45 S
0.05 W

Surface owned by Bessie Vincent.
Address: Mrs. Bessie Vincent, P.O. Box No. 173, Haywood, W. Va.
Coal owned by Bethlehem Coal Co. & Reppert Coal Mining Co.
Address: Gore Hotel Building, Clarksburg, W. Va.

New Location
Drill Deeper
Abandonment

On 800' Map N 31 E. Sqs. 56 E 16

Company Raad Supply Co.
 Address Salem, W. Va.
 Farm F. W. Cunningham
 Tract _____ Acres 1/3 Lease No. _____
 Well (Farm) No. 1 Serial No. _____
 Elevation (Spirit Level) Floor - 1004.17
Ground - 1002.13
 Quadrangle Clarksburg
 County Harrison District Eagle
 Engineer Elsworth Haines
 Engineer's Registration No. 2221
 File No. _____ Drawing No. _____
 Date Oct. 2nd, 1953 Scale 1" = 30 Feet

STATE OF WEST VIRGINIA
DEPARTMENT OF MINES
OIL AND GAS DIVISION
CHARLESTON

WELL LOCATION MAP
FILE NO. HAR-1605-A

+ Denotes location of well on United States Topographic Maps, scale 1 to 62,500, latitude and longitude lines being represented by border lines as shown.

- Denotes one inch spaces on border line of original tracing.



STATE OF WEST VIRGINIA
DEPARTMENT OF MINES
OIL AND GAS DIVISION

1481

1605A

WELL RECORD

Permit No. _____ Oil or Gas Well _____ (KIND)


Company Road Supply Company
Address 184 East Main St., Salem, W. Va.
Farm F. W. Cunningham Acres 1/3
Location (waters) _____
Well No. 1 Elev. 1004.77 DF
District Eagle County Harrison
The surface of tract is owned in fee by _____
Address _____
Mineral rights are owned by Bethlehem Coal Co.
& Reppert Coal Mining Co.,
Core Hotel Bldg., Clarksburg, W. Va.
Drilling commenced _____
Drilling completed _____
Date Shot _____ From No record To _____
With _____

Casing and Tubing	Used in Drilling	Left in Well	Packers
Size			Kind of Packer
16			
13	41'	41'	
10	96'	96'	Size of
8 1/2			
6 5/8	1407'	1407'	Depth set
5 3/16	2197'	2197'	
3			Perf. top
2	2442'	2442'	Perf. bottom
Liners Used			Perf. top
			Perf. bottom

Open Flow _____ /10ths Water in _____ Inch
_____ /10ths Merc. in _____ Inch
Volume _____ Cu. Ft.
Rock Pressure _____ lbs. _____ hrs.
Oil _____ bbls., 1st 24 hrs.
Fresh water _____ feet _____ feet
Salt water _____ feet _____ feet

CASING CEMENTED No SIZE _____ No. Ft. _____ Date _____
COAL WAS ENCOUNTERED 3A AT 45 FEET 96 INCHES
_____ FEET _____ INCHES FEET _____ INCHES
_____ FEET _____ INCHES FEET _____ INCHES

Formation	Color	Hard or Soft	Top	Bottom	Oil, Gas or Water	Depth Found	Remarks
Pittsburgh Coal			37	45			
Big Dunkard			580	625			
1st Salt Sand			790	1090			
Big Lime			1390	1460			
Big Injun Sand			1460	1530			
Gordon Stray Sand			2215	2245			
Gordon Sand			2262	2290			
4th Sand			2300	2340			
5th Sand			2418	2440			
Total Depth				2442			

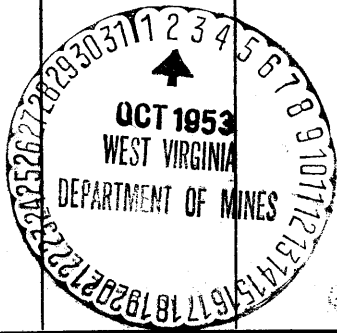

JAN 2 1954

(Over) JAN 2 1954

Formation	Color	Hard or Soft	Top	Bottom	Oil, Gas or Water	Depth Found	Remarks
							E 6

Date Oct 1, 1953

APPROVED Road Supply Co., Owner

By J. M. Road, my owner
(Title)