

New Location...
 Drill Deeper.....
 Abandonment.....

MAP SH. 44 Sq. 58 E 13 - F.B. 515 P. 31-33

Company HOPE NATURAL GAS Co.
 Address CLARKSBURG, W. VA.
 Farm O. W. Swiger
 Tract _____ Acres 100 Lease No. _____
 Well (Farm) No. _____ Serial No. 903
 Elevation (Spirit Level) 973'
 Quadrangle CLARKSBURG
 County HARRISON District EAGLE
 Engineer Guy H. Bradley
 Engineer's Registration No. 2425
 File No. _____ Drawing No. _____
 Date MARCH 3, 1954 Scale 1" = 500'

STATE OF WEST VIRGINIA
 DEPARTMENT OF MINES
 OIL AND GAS DIVISION
 CHARLESTON

WELL LOCATION MAP
 FILE NO. HAR-1613-A

+ Denotes location of well on United States Topographic Maps, scale 1 to 62,500, latitude and longitude lines being represented by border lines as shown.

- Denotes one inch spaces on border line of original tracing.



STATE OF WEST VIRGINIA
DEPARTMENT OF MINES
OIL AND GAS DIVISION

1502

WELL RECORD

Gas
Oil or Gas Well (KIND)

Permit No. 1613 A



Company Hope Natural Gas Company
 Address 445 West Main St., Clarksburg, W.Va.
 Farm Omer Swiger Acres 100
 Location (waters) _____
 Well No. 903 Elev. 973'
 District Eagle County Harrison
 The surface of tract is owned in fee by _____
 Address _____
 Mineral rights are owned by _____
 Address _____
 Drilling commenced February 28, 1907
 Drilling completed April 18, 1907
 Date Shot No record From _____ To _____
 With _____
 Open Flow /10ths Water in _____ Inch
 /10ths Merc. in _____ Inch
 Volume _____ Cu. Ft.
 Rock Pressure _____ lbs. _____ hrs.
 Oil _____ bbls., 1st 24 hrs.
 Fresh water 220', 610' feet 705' feet
 Salt water None recorded feet _____ feet

Casing and Tubing	Used in Drilling	Left in Well	Packers
Size			Kind of Packer
16			
13			
10			Size of
8 1/4	1190	1190	Depth set
6 5/8			
5 3/16	1820	1820	Perf. top
3			Perf. bottom
2		2280	Perf. top
Liners Used			Perf. bottom

CASING CEMENTED _____ SIZE _____ No. Ft. _____ Date _____
No Cementing done

COAL WAS ENCOUNTERED AT _____ FEET _____ INCHES
Below Pittsburgh Coal
 _____ FEET _____ INCHES _____ FEET _____ INCHES
 _____ FEET _____ INCHES _____ FEET _____ INCHES

Formation	Color	Hard or Soft	Top	Bottom	Oil, Gas or Water	Depth Found	Remarks
Little Dunkard			235	275		Water	225'
Big Dunkard			335	390			
Gas Sand			600	710	Water	610 & 705	
Salt Sand			850	900			
Red Rock			935	1130			
Big Lime			1165	1235			
Big Injun			1235	1335			
Fifty Foot			1735	1790			
Thirty Foot			1792	1865			
Stray			1915	1990			
Gordon			1990	2042			
Fourth Sand			2070	2100			
Fifth Sand			2221	2231	Gas	2223	
Total Depth				2267'			

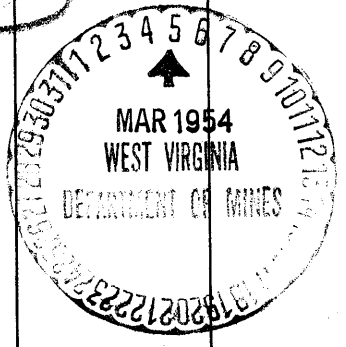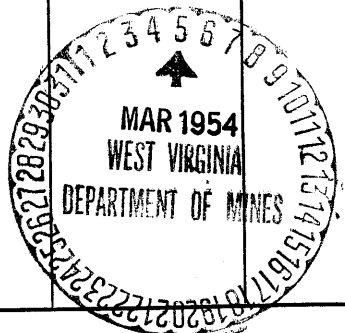

(Over) NOV 12 1954

Formation	Color	Hard or Soft	Top	Bottom	Oil, Gas or Water	Depth Found	Remarks

Date March 4, 19 54

APPROVED Hope Natural Gas Company, Owner

By _____ (Title)

Sailey