



Latitude 39° 15'

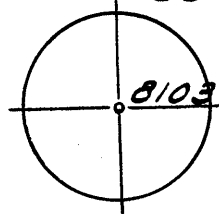

0.825
1.70 W

Longitude 80° 25'

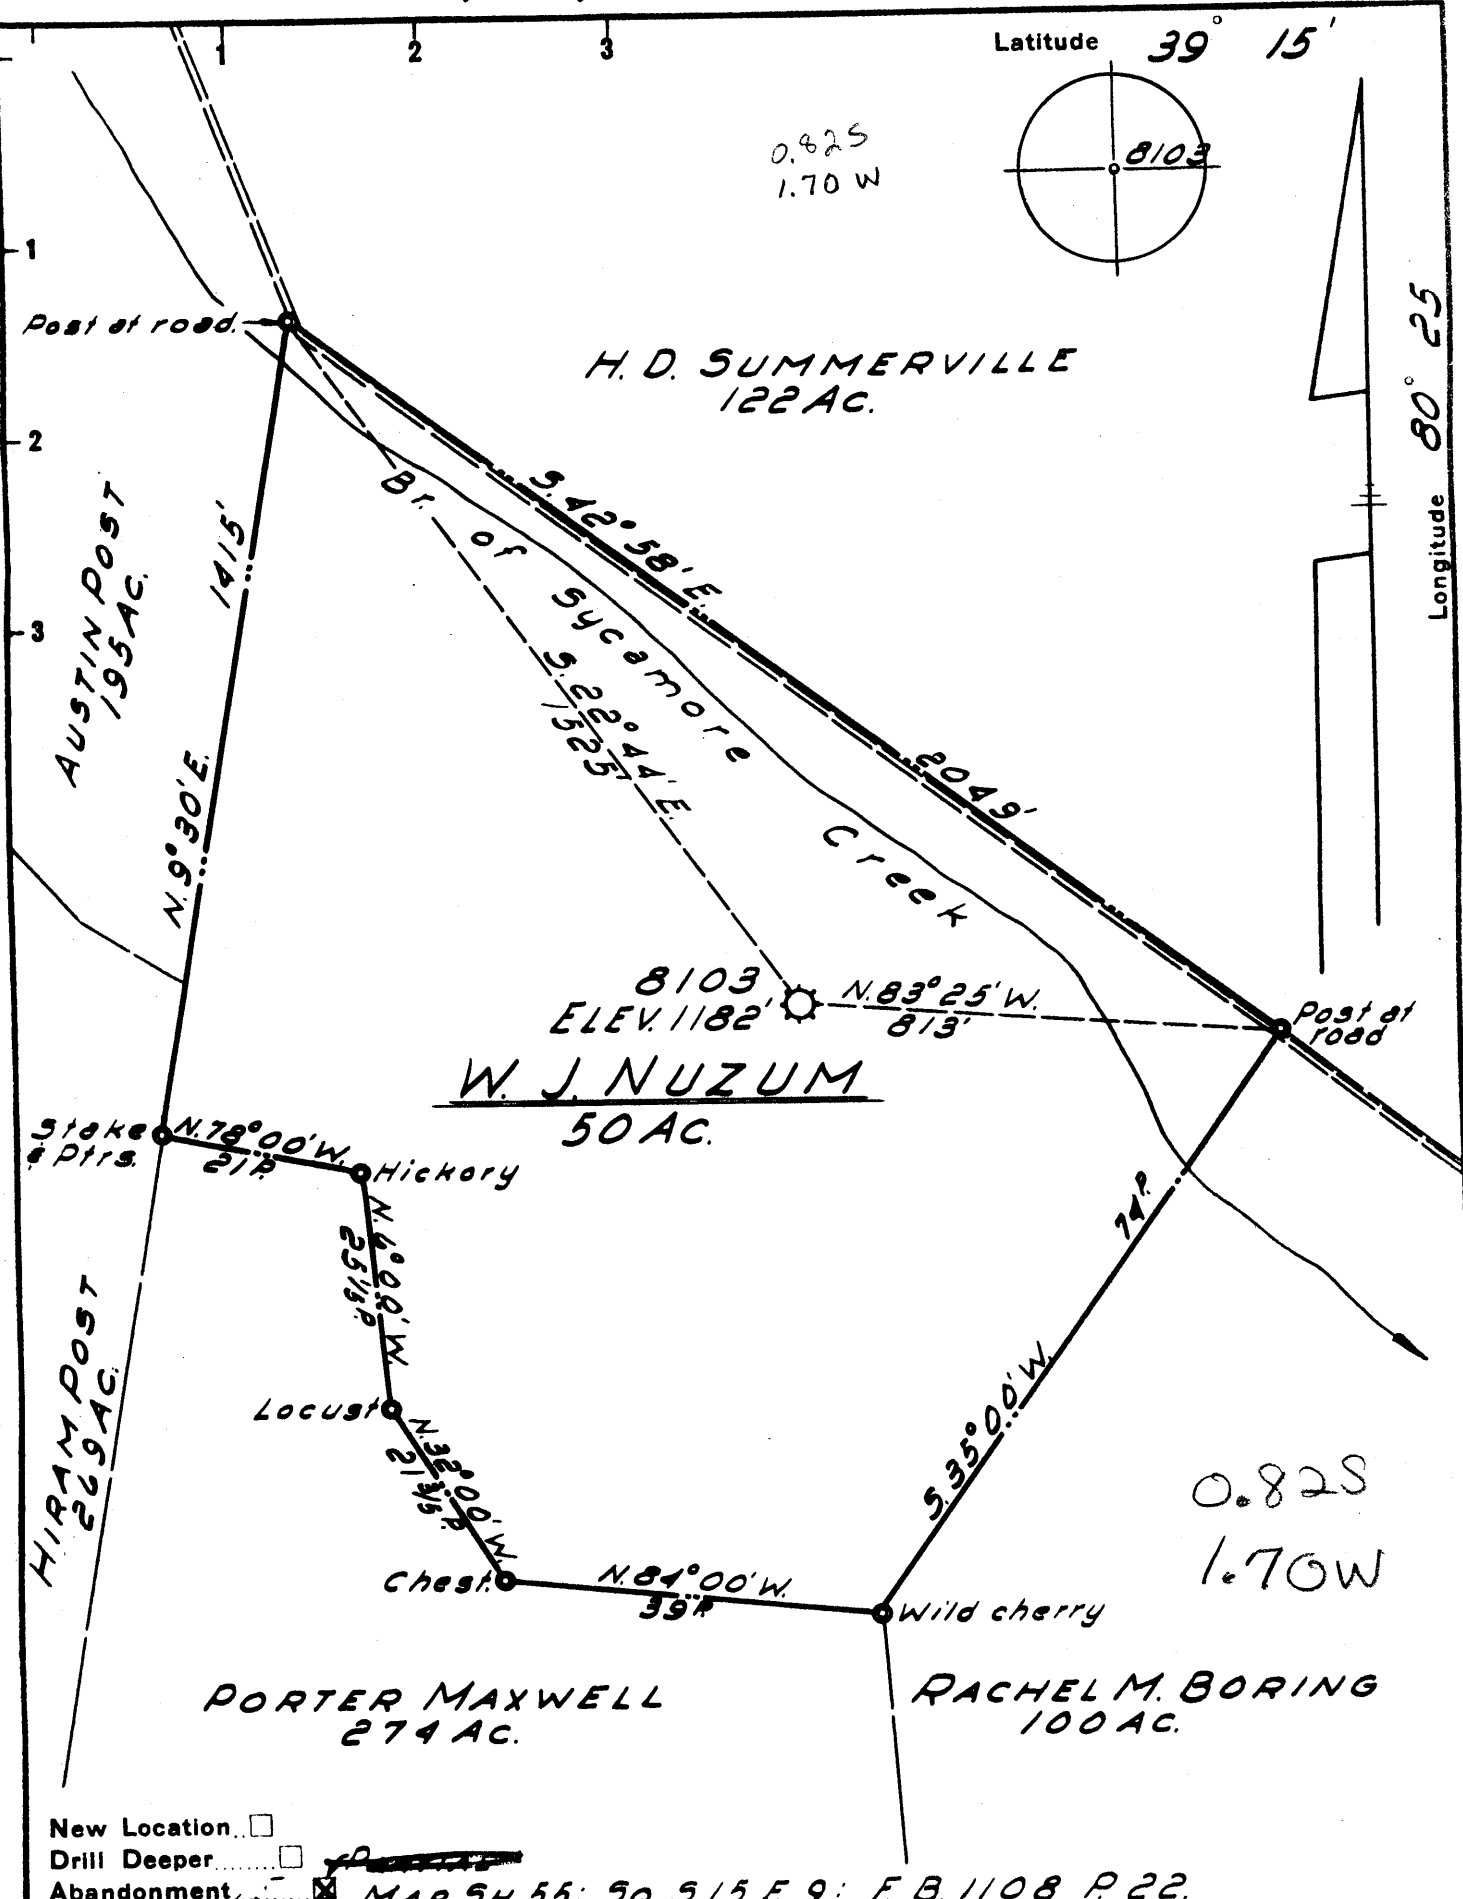

New Location

Drill Deeper

Abandonment

MAP 5H.55: 5Q. 5.15 E. 9: F. B. 1108 P. 22.

Company CONSOLIDATED GAS SUPPLY CORPORATION

Address CLARKSBURG, WEST VA.

Farm W. J. NUZUM

Tract _____ Acres 50 Lease No. 52892

Well (Farm) No. _____ Serial No. 8103

Elevation (Spirit Level) 1182'

Quadrangle WESTON NW

County HARRISON District UNION

Engineer W. M. B. Curran

Engineer's Registration No. 900

File No. _____ Drawing No. _____

Date 7-20-54 Scale 1" = 20 POLES

STATE OF WEST VIRGINIA
DEPARTMENT OF MINES
OIL AND GAS DIVISION
CHARLESTON

WELL LOCATION MAP

FILE NO. HAR-1619-A

~~PARTIAL FLOODING~~

+ Denotes location of well on United States Topographic Maps, scale 1 to 62,500, latitude and longitude lines being represented by border lines as shown.

- Denotes one inch spaces on border line of original tracing.

47-033



STATE OF WEST VIRGINIA
DEPARTMENT OF MINES
OIL AND GAS DIVISION

1501

Quadrangle Weston
119A

WELL RECORD

Oil or Gas Well Gas
(KIND)

Permit No. _____
Company Hope Natural Gas Company
Address 445 West Main St., Clarksburg, W. Va.
Farm W. J. Nuzum Acres 50
Location (waters) _____
Well No. 8103 Elev. 1187
District Union County Harrison
The surface of tract is owned in fee by _____
Address _____
Mineral rights are owned by _____
Address _____
Drilling commenced 1-11-17
Drilling completed 2-24-17
Date Shot 5-17-21 From 3033 To 3041
With 20 Quarts Nitro
Open Flow /10ths Water in _____ Inch
/10ths Merc. in _____ Inch
Volume _____ Cu. Ft.
Rock Pressure _____ lbs. _____ hrs.
Oil None Recorded bbls., 1st 24 hrs.
Fresh water No Record feet _____ feet
Salt water No Record feet _____ feet

Casing and Tubing	Used in Drilling	Left in Well	Packers
Size			Kind of Packer
16			
13			
10			Size of
8 3/4	<u>488</u>	<u>488</u>	
6 3/4	<u>1450</u>	<u>1450</u>	Depth set
5 3/16			
3			Perf. top
2	<u>3068</u>	<u>Pulled</u>	Perf. bottom
Liners Used			Perf. top
			Perf. bottom

CASING CEMENTED _____ SIZE _____ No. Ft. _____ Date _____
No Cementing
COAL WAS ENCOUNTERED AT Below Coal FEET _____ INCHES
_____ FEET _____ INCHES FEET _____ INCHES
_____ FEET _____ INCHES FEET _____ INCHES

Formation	Color	Hard or Soft	Top	Bottom	Oil, Gas or Water	Depth Found	Remarks
Big Dunkard			520	585			
Gas Sand			675	760			
First Salt			805	920			
2nd Salt			965	1010			
Little Lime			1350	1360			
Pencil Cave			1365	1370			
Big Lime			1370	1423			
Big Injun			1423	1540	Gas	1527	
Squaw			1590	1633			
Gantz			1855	1878			
Fifty Foot			2007	2027	Gas	2010	
Thirty Foot			Shells				
Gordon Stray			2110	2160	Gas	2135-45	
Gordon			2186	2210			
Fourth			2258	2265			
Fifth			2338	2350	Gas	2340-45	
Bayard			2438	2445			
Speechley			3032	3038	Gas	3033	
Total Depth				3063'			



