

LATITUDE

39°17'30"

80°22'30"

LONGITUDE



7'5 OGIS topo location

7.5' loc,	<u>125</u>	15' loc	_____
	<u>2.18w</u>	(calc.)	_____

Company _____

Farm _____

Quad Wolf Summit


County Harr

District Clark

WELL LOCATION MAP

File No. 31630

J.E. MORRISON
90 AC.

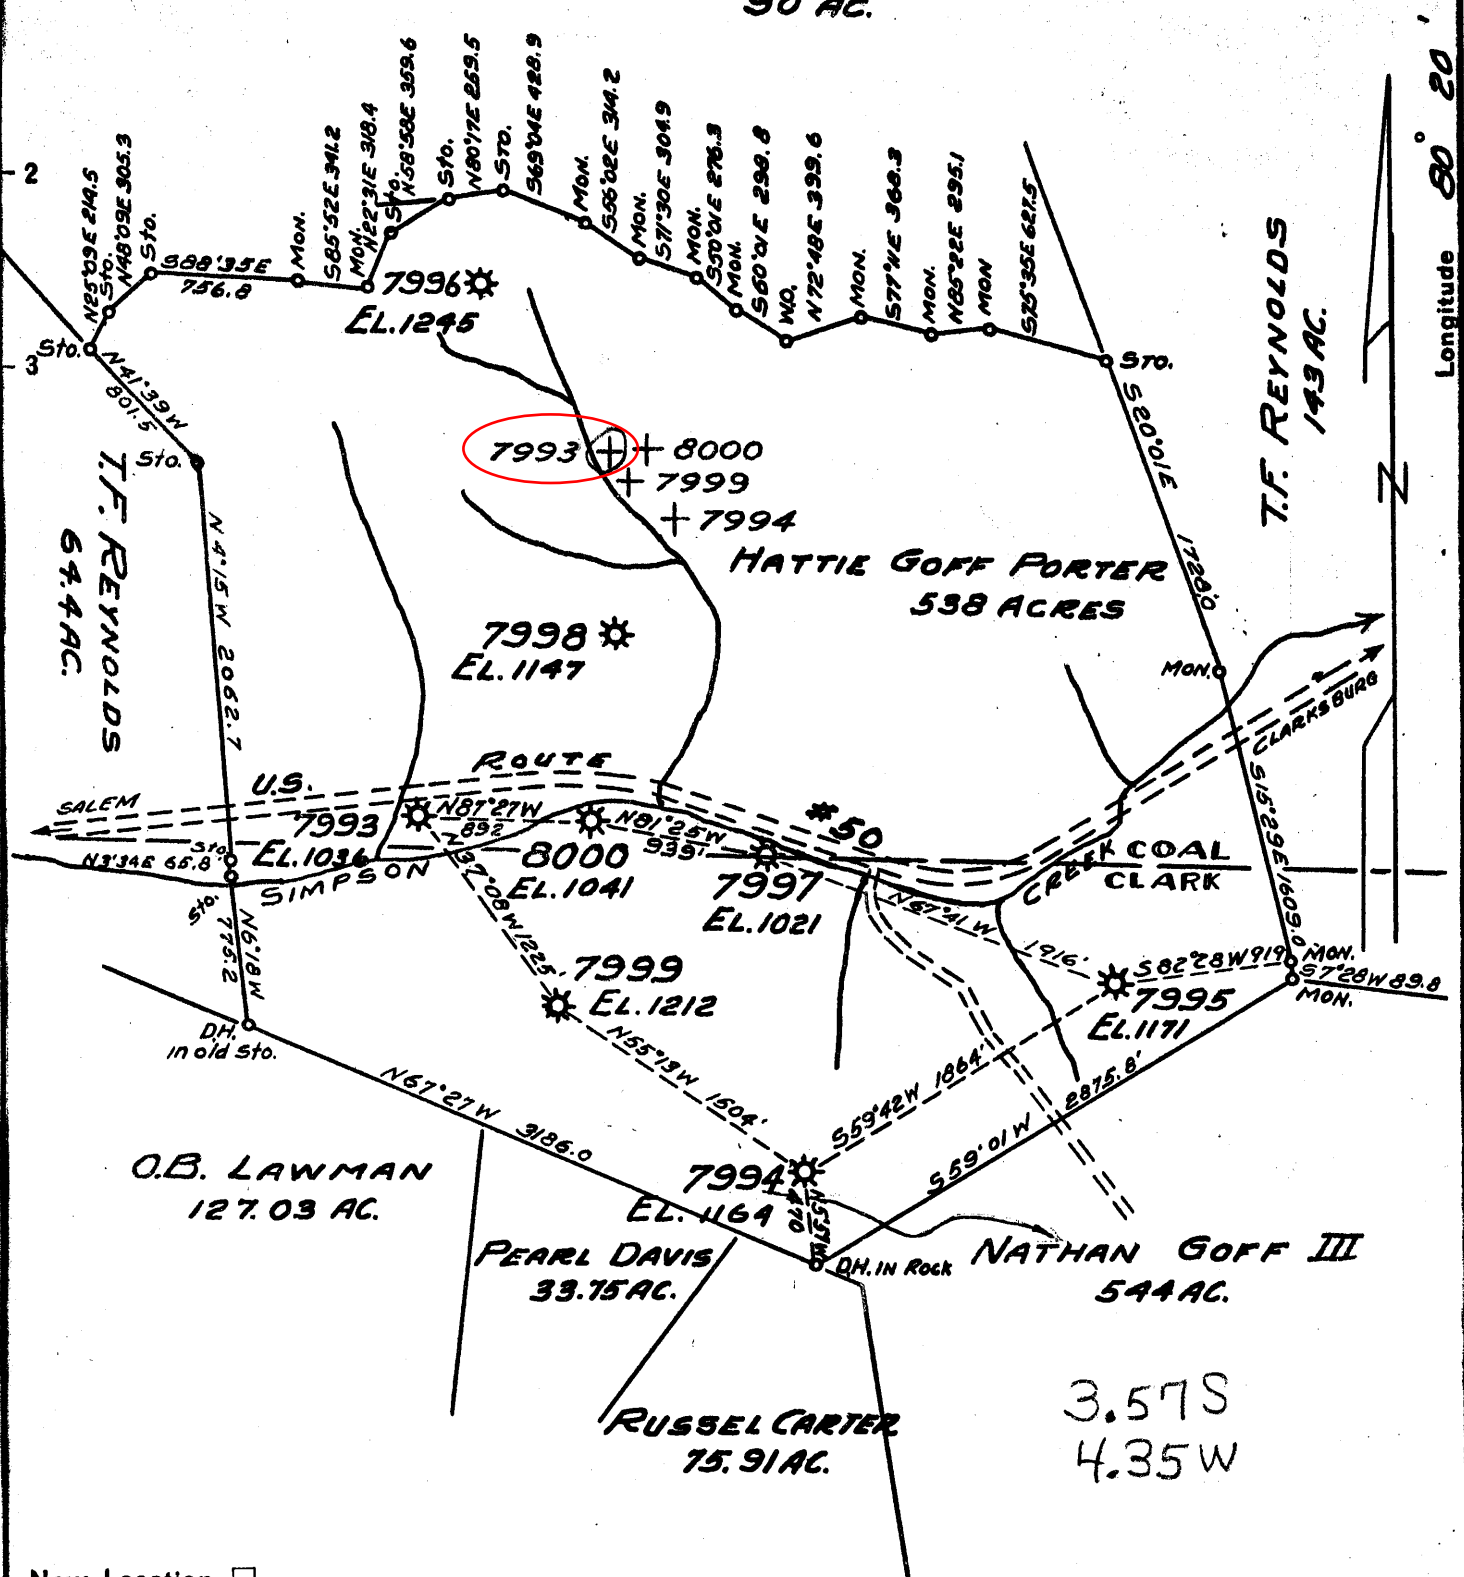

New Location...
 Drill Deeper...
 Abandonment... 7993

MAP SHT. 44 512-13 E 11-12 FB1080

Company HOPE NATURAL GAS CO.
 Address CLARKSBURG W.VA.
 Farm HATTIE GOFF PORTER
 Tract _____ Acres 538 Lease No. 52723
 Well (Farm) No. _____ Serial No. AS SHOWN
 Elevation (Spirit Level) AS SHOWN
 Quadrangle CLARKSBURG
 County HARRISON District COAL & CLARK
 Engineer Guy H. Bradley
 Engineer's Registration No. 2425
 File No. _____ Drawing No. _____
 Date JUNE 15, 1955 Scale 1" = 1000'

STATE OF WEST VIRGINIA
 DEPARTMENT OF MINES
 OIL AND GAS DIVISION
 CHARLESTON

WELL LOCATION MAP
 FILE NO. HAR-1630-A

+ Denotes location of well on United States Topographic Maps, scale 1 to 62,500, latitude and longitude lines being represented by border lines as shown.

- Denotes one inch spaces on border line of original tracing.



STATE OF WEST VIRGINIA
DEPARTMENT OF MINES
OIL AND GAS DIVISION

1513

Quadrangle Clarksburg

Permit No. 7993

WELL RECORD

Oil or Gas Well Gas
(KIND)

Company Hope Natural Gas Company
Address 445 West Main St., Clarksburg, W. Va.
Farm Hattie Goff Porter Acres 538
Location (waters) _____
Well No. 7993 Elev. 1036'
District Clark County Harrison
The surface of tract is owned in fee by _____
Address _____
Mineral rights are owned by _____
Address _____
Drilling commenced Dec. 24, 1902
Drilling completed Feb. 8, 1902
Date Shot Not shot From _____ To _____
With _____

Casing and Tubing	Used in Drilling	Left in Well	Packers
Size			
16			Kind of Packer _____
13			
10			Size of _____
8 1/4			
6 5/8	1240	1240	Depth set _____
5 3/16			
3	2050	2050	Perf. top _____
2			Perf. bottom _____
Liners Used			Perf. top _____
			Perf. bottom _____

Open Flow /10ths Water in _____ Inch
/10ths Merc. in _____ Inch
Volume 14 M Cu. Ft.
Rock Pressure _____ lbs. _____ hrs.
Oil None bbls., 1st 24 hrs.
Fresh water Not recorded feet _____ feet
Salt water do feet _____ feet

CASING CEMENTED _____ SIZE _____ No. Ft. _____ Date _____
None
COAL WAS ENCOUNTERED AT _____ FEET _____ INCHES
No Coal (Below)
FEET _____ INCHES FEET _____ INCHES
FEET _____ INCHES FEET _____ INCHES

Formation	Color	Hard or Soft	Top	Bottom	Oil, Gas or Water	Depth Found	Remarks
Surface			0	16			
Dunkard Sand			440	?			
Gas Sand			625	?	Gas	630	Show
Salt Sand			710	920			
Maxon Sand			970	?			
Big Lime			1180	1240			
Big Injun			1240	1345			
Fifty Foot			1780	?			
Stray			2035	?			
Gordon			2050		Gas	2050	
TOTAL DEPTH				2050'			



OCT 6 1955

Formation	Color	Hard or Soft	Top	Bottom	Oil, Gas or Water	Depth Found	Remarks

Date June 16, _____, 1955

APPROVED Hope Natural Gas Company Owner
 By _____ B. R. NUZUM
 (Title) General Superintendent
 By Garley