

2.708  
0.25W

New Location...   
 Drill Deeper.....   
 Abandonment.....

Map Sh. 42 S12E20 FB 525P24

Company Hope Natural Gas Co.  
 Address Clarksburg, W.Va.  
 Farm Marshall Jaynes  
 Tract \_\_\_\_\_ Acres 8 Lease No. 45518  
 Well (Farm) No. \_\_\_\_\_ Serial No. 7594  
 Elevation (Spirit Level) 1046'  
 Quadrangle Clarksburg  
 County Harrison District Simpson  
 Engineer W.M. Bowers  
 Engineer's Registration No. 900  
 File No. \_\_\_\_\_ Drawing No. \_\_\_\_\_  
 Date July 18, 1955 Scale 1" = 200'

STATE OF WEST VIRGINIA  
 DEPARTMENT OF MINES  
 OIL AND GAS DIVISION  
 CHARLESTON

WELL LOCATION MAP  
 FILE NO. HAR-1633-A

+ Denotes location of well on United States Topographic Maps, scale 1 to 62,500, latitude and longitude lines being represented by border lines as shown.  
 - Denotes one inch spaces on border line of original tracing.



STATE OF WEST VIRGINIA  
DEPARTMENT OF MINES  
OIL AND GAS DIVISION

1516

Quadrangle Clarksburg

**WELL RECORD**

Permit No. 1633A


Oil or Gas Well Gas  
(KIND)

Company Hope Natural Gas Company  
Address 445 West Main St., Clarksburg, W. Va.  
Farm Marshall Jaynes Acres 8  
Location (waters) \_\_\_\_\_  
Well No. 7594 Elev. 1046'  
District Simpson County Harrison  
The surface of tract is owned in fee by \_\_\_\_\_  
Address \_\_\_\_\_  
Mineral rights are owned by \_\_\_\_\_  
Address \_\_\_\_\_  
Drilling commenced No record  
Drilling completed No record  
Date Shot No record From \_\_\_\_\_ To \_\_\_\_\_  
With \_\_\_\_\_  
Open Flow \_\_\_\_\_ /10ths Water in \_\_\_\_\_ Inch  
\_\_\_\_\_ /10ths Merc. in \_\_\_\_\_ Inch  
Volume ? Cu. Ft.  
Rock Pressure \_\_\_\_\_ lbs. \_\_\_\_\_ hrs.  
Oil None bbls., 1st 24 hrs.  
Fresh water None recorded feet \_\_\_\_\_ feet  
Salt water None feet \_\_\_\_\_ feet

Casing and Tubing	Used in Drilling	Left in Well	Packers
Size			
16			Kind of Packer
13			
10			Size of
8 1/4			
6 3/4			Depth set
5 3/16			
3			Perf. top
2	2320	2320	Perf. bottom
Liners Used			Perf. top
			Perf. bottom

CASING CEMENTED \_\_\_\_\_ SIZE \_\_\_\_\_ No. Ft. \_\_\_\_\_ Date \_\_\_\_\_  
Well cemented solid outside 2" tubing  
COAL WAS ENCOUNTERED AT \_\_\_\_\_ FEET \_\_\_\_\_ INCHES  
No Coal  
\_\_\_\_\_ FEET \_\_\_\_\_ INCHES FEET \_\_\_\_\_ INCHES  
\_\_\_\_\_ FEET \_\_\_\_\_ INCHES FEET \_\_\_\_\_ INCHES

Formation	Color	Hard or Soft	Top	Bottom	Oil, Gas or Water	Depth Found	Remarks
First Salt			480	<del>530</del> 530			
Second Salt			550	585			
Third Salt			615	710			
Big Lime			1212	1282			
Big Injun			1282	1362	Gas	1290 - 1300	
Fifth Sand			2275	2315			
Total Depth				2320'			

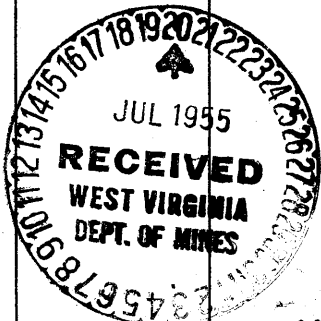

Hope Natural Gas Company  
JAN. 23 1956 July 19, 1955  
B. R. NUZUM  
General Superintendent  
By Pailey