


TOWN OF SALEM

Tenmile Creek

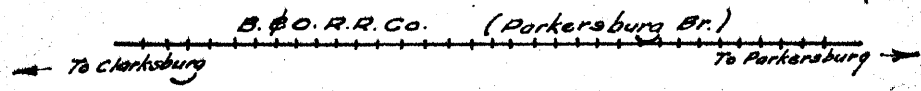

3.68S
3.90W

No coal mined in this vicinity
Surface owned by Mrs. Laura Randolph of Salem, W. Va.
Well formerly owned by South Penn Nat Gas Co.

New Location...
Drill Deeper.....
Abandonment.....

Company REX MASON & CO.
 Address Route 1, Parkersburg, W. Va.
 Farm Lloyd Randolph
 Tract _____ Acres 109 1/4 Lease No. _____
 Well (Farm) No. Two Serial No. _____
 Elevation (Spirit Level) 921'
 Quadrangle Centerpoint
 County Harrison District Tenmile
 Engineer W. S. Bleck Jr.
 Engineer's Registration No. 1227
 File No. _____ Drawing No. _____
 Date June, 1956 Scale 1" = 40'

STATE OF WEST VIRGINIA
DEPARTMENT OF MINES
OIL AND GAS DIVISION
CHARLESTON

WELL LOCATION MAP
FILE NO. HAR-1655-A

+ Denotes location of well on United States Topographic Maps, scale 1 to 62,500, latitude and longitude lines being represented by border lines as shown.

- Denotes one inch spaces on border line of original tracing.



STATE OF WEST VIRGINIA
DEPARTMENT OF MINES
OIL AND GAS DIVISION

1539

Centerpoint
655A

WELL RECORD

Permit No. 655A Reynolds Oil or Gas Well X (KIND)


Company South Penn Natural Gas Company
Address Parkersburg, West Virginia
Farm Lloyd Randolph Acres 109 1/2
Location (waters) Ten Mile Creek
Well No. 2 Elev. 921'
District Tennile County Harrison
The surface of tract is owned in fee by Mrs. Laura Randolph
alph Address Salem, W. Va.
Mineral rights are owned by No Coal Mined in this
Vicinity Address _____

Casing and Tubing	Used in Drilling	Left in Well	Packers
Size			
16			Kind of Packer _____
13			
10	<u>298'</u>	<u>None</u>	Size of _____
8 1/4	<u>1423'</u>	<u>1423'</u>	
6 5/8	<u>2409'</u>	<u>2409'</u>	Depth set _____
5 3/16			
3			Perf. top _____
2			Perf. bottom _____
Liners Used	<u>2 1/2" - 5 X 5 1/2"</u>		Perf. top _____
	<u>Top at</u>	<u>2312'</u>	Perf. bottom _____

Drilling commenced _____
Drilling completed _____
Date Shot 4-13-07 From 2949' To _____
With 20 qts.
Open Flow _____ /10ths Water in _____ Inch
_____ /10ths Merc. in _____ Inch
Volume _____ Cu. Ft.
Rock Pressure _____ lbs. _____ hrs.
Oil _____ bbls., 1st 24 hrs.
Fresh water _____ feet _____ feet
Salt water _____ feet _____ feet

CASING CEMENTED _____ SIZE _____ No. Ft. _____ Date _____
COAL WAS ENCOUNTERED AT 906' FEET _____ INCHES
_____ FEET _____ INCHES FEET _____ INCHES
_____ FEET _____ INCHES FEET _____ INCHES

Formation	Color	Hard or Soft	Top	Bottom	Oil, Gas or Water	Depth Found	Remarks
<u>Pittsburgh Coal</u>			<u>906'</u>	<u>913'</u>			
<u>Dunkard Sand</u>			<u>1420'</u>	<u>1449'</u>			
<u>Salt Sand</u>			<u>1781'</u>	<u>1886'</u>			
<u>Maxon Sand</u>			<u>2092'</u>	<u>2107'</u>			
<u>Big Lime</u>			<u>2166'</u>	<u>2222'</u>			
<u>Big Injun</u>			<u>2222'</u>	<u>2310'</u>			
<u>50' Sand</u>			<u>2770'</u>	<u>2800'</u>			
<u>Stray Sand</u>			<u>2902'</u>	<u>2927'</u>			
<u>Garden Sand</u>			<u>2946'</u>	<u>2958'</u>			
<u>TOTAL DEPTH</u>				<u>2959'</u>			

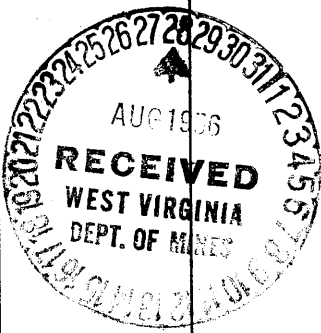

MAR 28 1957