


Latitude 39° 20'

Longitude 80° 15'

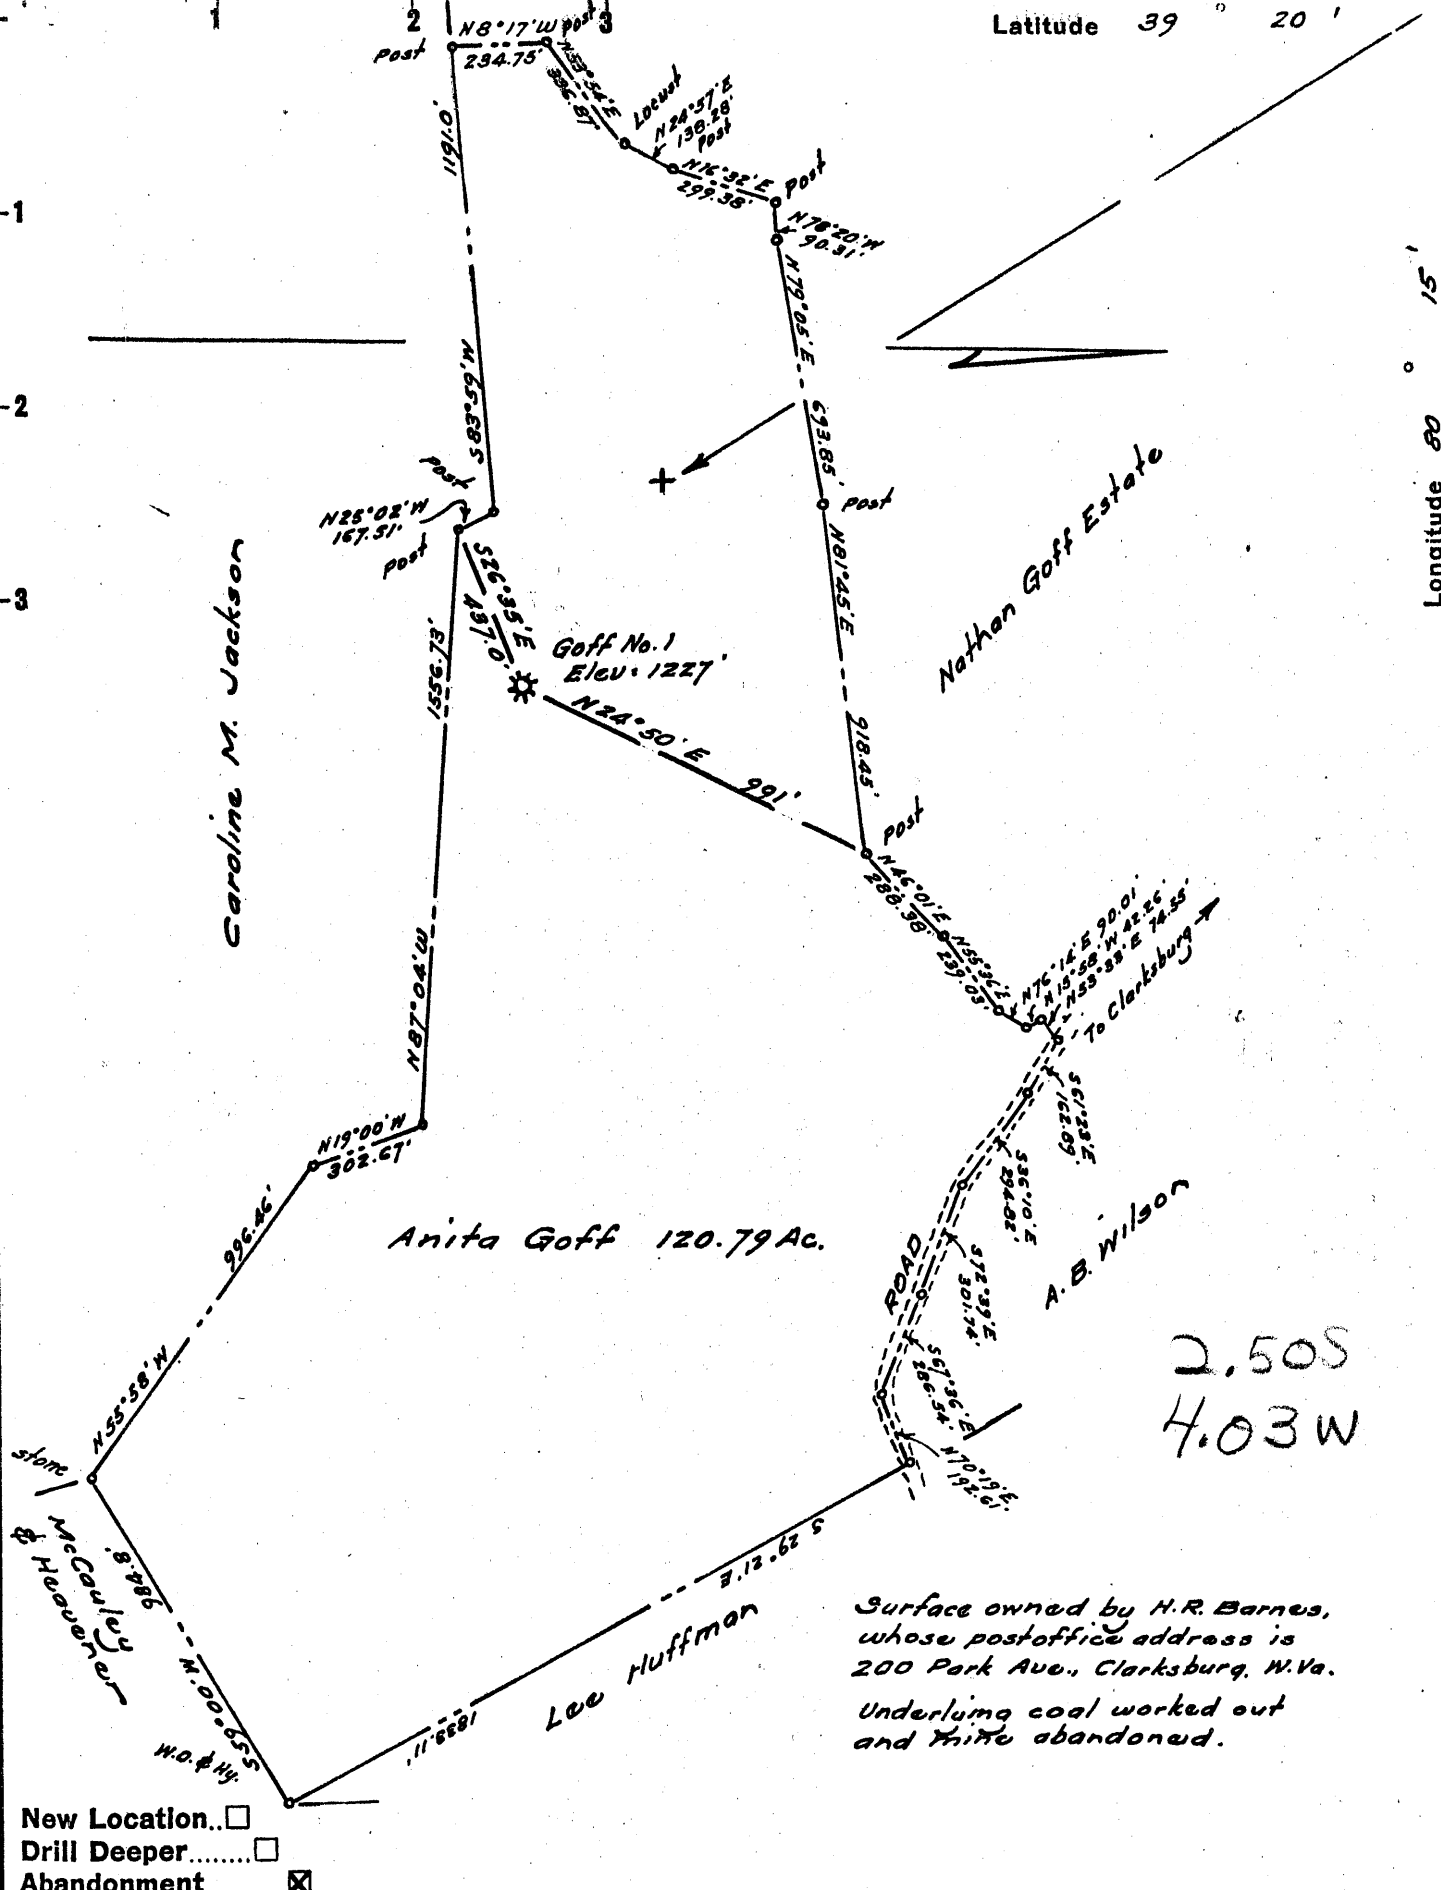

2.50S
4.03W

- New Location...
- Drill Deeper.....
- Abandonment.....

Company DELEWARE GAS CO.

Address Goff Bldg., Clarksburg, W.Va.

Farm Anita Goff

Tract _____ Acres 120.79 Lease No. _____

Well (Farm) No. FOUR Serial No. _____

Elevation (Spirit Level) 1227

Quadrangle Clarksburg SE

County Harrison District Coal

Engineer W. S. [Signature]

Engineer's Registration No. 1227

File No. _____ Drawing No. _____

Date August, 1956 Scale 1" = 500'

STATE OF WEST VIRGINIA
DEPARTMENT OF MINES
OIL AND GAS DIVISION
CHARLESTON

WELL LOCATION MAP
FILE NO. HAR-1652-A

+ Denotes location of well on United States Topographic Maps, scale 1 to 62,500, latitude and longitude lines being represented by border lines as shown.

- Denotes one inch spaces on border line of original tracing.

(112)



STATE OF WEST VIRGINIA
DEPARTMENT OF MINES
OIL AND GAS DIVISION

1238

Quadrangle Clarksburg

Permit No. 1658-A

WELL RECORD

Oil or Gas Well Gas
(KIND)

Company Delaware Gas Company
Address P. O. Box 225, Clarksburg, West Va.
Farm Smith Goff Acres 120.79
Location (waters) _____
Well No. 4 Elev. 1227
District Coal County Harrison
The surface of tract is owned in fee by _____
Address _____
Mineral rights are owned by _____
Address _____
Drilling commenced _____
Drilling completed April 11, 1925
Date Shot _____ From _____ To _____
With _____
Open Flow /10ths Water in _____ Inch
/10ths Merc. in _____ Inch
Volume _____ Cu. Ft.
Rock Pressure _____ lbs. _____ hrs.
Oil _____ bbls., 1st 24 hrs.
Fresh water _____ feet _____ feet
Salt water _____ feet _____ feet

Casing and Tubing	Used in Drilling	Left in Well	Packers
Size			Kind of Packer
16			<u>Anchor</u>
13			Size of <u>2"</u>
10		<u>278</u>	Depth set <u>2317</u>
8 1/4 (Not showing)		<u>1227</u>	
6 5/8		<u>1637</u>	
5 3/16			
3			Perf. top _____
2		<u>2682</u>	Perf. bottom _____
Liners Used			Perf. top _____
			Perf. bottom _____

CASING CEMENTED 1 1/2" SIZE No. Ft. _____ Date _____
COAL WAS ENCOUNTERED AT _____ FEET _____ INCHES
_____ FEET _____ INCHES FEET _____ INCHES
_____ FEET _____ INCHES FEET _____ INCHES

Formation	Color	Hard or Soft	Top	Bottom	Oil, Gas or Water	Depth Found	Remarks
Pittsburgh Coal			179	187			
L. Dunkard			502	590			
B. Dunkard			613	655			
Gas Sand			735	765			
1st Salt			825	853			
2nd Salt			920	940	Water 983		
3rd Salt			948	1211			
Maxon			1455	1500			
L. Lime			1553	1560			
Pencil Cave			1560	1595			
Big Lime			1595	1655			
Big Injun			1655	1768			
50 Foot			2115	2167			
30 Foot			2177	2335			
5th Sand			2620	2665	Gas 2622		
Total Depth -				2682			



MAR 28 1937

(Over)