

New Location   
 Drill Deeper   
 Abandonment

Wilhelm & Jackson - Hamlin, W. Va.

Company A. M. Snider  
 Address 60 Sunset Dr. Fairmont, W. Va.  
 Farm J. A. Gawthorn  
 Tract \_\_\_\_\_ Acres 97 Lease No. \_\_\_\_\_  
 Well (Farm) No. 7923 Serial No. \_\_\_\_\_  
 Elevation (spirit Level) 1311  
 Quadrangle Clarksburg  
 County Harrison District Ten Mile  
 Engineer Maris H. Helghman  
 Engineer's Registration No. 1868  
 File No. 1 Drawing No. 3  
 Date Jan. 27, 1959 Scale 1" = 80 P.

STATE OF WEST VIRGINIA  
 DEPARTMENT OF MINES  
 OIL AND GAS DIVISION  
 CHARLESTON

WELL LOCATION MAP  
 FILE NO. HAR-1686-A

+ Denotes location of well on United States Topographic Maps, scale 1 to 62,500, latitude and longitude lines being represented by border lines as shown.  
 - Denotes one inch spaces on border line of original tracing.



176

STATE OF WEST VIRGINIA  
DEPARTMENT OF MINES  
OIL AND GAS DIVISION

Quadrangle Clackson  
Permit No. 1686-A

WELL RECORD

Oil or Gas Well Gas  
(KIND)

Company Wilhelm & Jackson, Inc.  
Address 508 Buckhannon Ave.  
Farm J. A. Gawthrop Acres 97  
Location (waters) Davisson Run  
Well No. HNG 7923 Elev. 1911  
District Clark County Harrison  
The surface of tract is owned in fee by J. A. Gawthrop  
Mineral rights are owned by \_\_\_\_\_  
Drilling commenced April 6 1910  
Drilling completed April June 24, 1910  
Date Shot \_\_\_\_\_ From \_\_\_\_\_ To \_\_\_\_\_  
With \_\_\_\_\_  
Open Flow \_\_\_\_\_ /10ths Water in \_\_\_\_\_ Inch  
\_\_\_\_\_ /10ths Merc. in \_\_\_\_\_ Inch  
Volume \_\_\_\_\_ Cu. Ft.  
Rock Pressure \_\_\_\_\_ lbs. \_\_\_\_\_ hrs.  
Oil \_\_\_\_\_ bbls., 1st 24 hrs.  
WELL ACIDIZED \_\_\_\_\_  
WELL FRACTURED \_\_\_\_\_


Casing and Tubing	Used in Drilling	Left in Well	Packers
Size			Kind of Packer
16			
13			
10	185	185'	Size of
8 1/4	1170		
6 5/8	1612	1612'	Depth set
5 3/16	1622'	1622'	
3			Perf. top
2			Perf. bottom
Liners Used	5 3/16"	484'	Perf. top
			Perf. bottom

CASING CEMENTED \_\_\_\_\_ SIZE \_\_\_\_\_ No. Ft. \_\_\_\_\_ Date \_\_\_\_\_

COAL WAS ENCOUNTERED AT 145' FEET \_\_\_\_\_ INCHES  
\_\_\_\_\_ FEET \_\_\_\_\_ INCHES \_\_\_\_\_ FEET \_\_\_\_\_ INCHES  
\_\_\_\_\_ FEET \_\_\_\_\_ INCHES \_\_\_\_\_ FEET \_\_\_\_\_ INCHES

RESULT AFTER TREATMENT \_\_\_\_\_  
ROCK PRESSURE AFTER TREATMENT \_\_\_\_\_  
Fresh Water \_\_\_\_\_ Feet \_\_\_\_\_ Salt Water \_\_\_\_\_ Feet \_\_\_\_\_

Formation	Color	Hard or Soft	Top	Bottom	Oil, Gas or Water	Depth	Remarks
Pittsburg Coal			145	151			
Dunkard Sand			595	760			
Salt Sand			850	1135			
Lime Sand			1550	1620			
Injun Sand			1620	1740			
Squaw			1760	1890			
Fifty Foot Sand			2110	2192			
Thirty Foot Sand			2190	2220			
Stray Sand			2272	2340			
Gordon Sand			2363	2390			
Fifth Sand			2395	2435			
Fifth Sand			2530	2544			
Total Depth				2547			

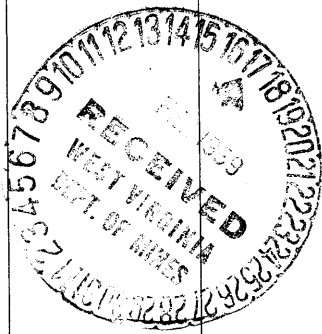

JUL 23 1959