


4.20S
3.20W

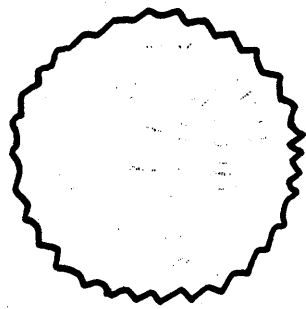

New Location
 Drill Deeper
 Abandonment

Company	<u>A. M. Snider</u>
Address	<u>60 Sunset Dr., Fairmont, W. Va.</u>
Farm	<u>Wesley Cork</u>
Tract	Acres <u>25</u> Lease No. _____
Well (Farm) No.	<u>7346</u> Serial No. _____
Elevation (Spirit Level)	<u>1076</u>
Quadrangle	<u>Clarksburg</u>
County	<u>Harrison</u> District <u>Clark</u>
Engineer	<u>Marvin H. Lehman</u>
Engineer's Registration No.	<u>1868</u>
File No.	<u>1</u> Drawing No. <u>4</u>
Date	<u>Jan. 27, 1959</u> Scale <u>1" = 80 P.</u>

STATE OF WEST VIRGINIA
 DEPARTMENT OF MINES
 OIL AND GAS DIVISION
 CHARLESTON

WELL LOCATION MAP
 FILE NO. HRR-1691-A

+ Denotes location of well on United States Topographic Maps, scale 1 to 62,500, latitude and longitude lines being represented by border lines as shown.
 - Denotes one inch spaces on border line of original tracing.



1560

STATE OF WEST VIRGINIA
DEPARTMENT OF MINES
OIL AND GAS DIVISION

Quadrangle Clarksburg

Permit No. 1691-A

WELL RECORD

Oil or Gas Well GAS
(KIND)

Company Wilhelm & Jackson, Inc.
Address 508 Buckhannon Ave., Clarksburg, W.Va.
Farm Wesley Cork Acres 25
Location (waters) _____
Well No. H.N.G. #7346 Elev. 1076
District Clark County Harrison
The surface of tract is owned in fee by Wesley Cork
Address Clarksburg, W.Va.
Mineral rights are owned by Wesley Cork
Address _____

Casing and Tubing	Used in Drilling	Left in Well	Packers
Size			
16			Kind of Packer _____
13			<u>Hook Wall</u>
10			Size of <u>5 x 6</u>
8 1/4	<u>950</u>	<u>950</u>	
6 3/8	<u>1390</u>	<u>1390</u>	Depth set <u>1407</u>
5 3/16	<u>1407</u>	<u>1407</u>	
3			Perf. top _____
2			Perf. bottom _____
Liners Used			Perf. top _____
			Perf. bottom _____

Drilling commenced April 21, 1917
Drilling completed June 6, 1917
Date Shot _____ From _____ To _____
With _____
Open Flow _____ /10ths Water in _____ Inch
_____ /10ths Merc. in _____ Inch
Volume _____ Cu. Ft.
Rock Pressure _____ lbs. _____ hrs.
Oil _____ bbls., 1st 24 hrs.
WELL ACIDIZED _____
WELL FRACTURED _____

CASING CEMENTED _____ SIZE _____ No. Ft. _____ Date _____

COAL WAS ENCOUNTERED AT _____ FEET _____ INCHES
_____ FEET _____ INCHES FEET _____ INCHES
_____ FEET _____ INCHES FEET _____ INCHES

RESULT AFTER TREATMENT _____

ROCK PRESSURE AFTER TREATMENT _____

Fresh Water _____ Feet Salt Water _____ Feet

Formation	Color	Hard or Soft	Top	Bottom	Oil, Gas or Water	Depth	Remarks
L. Dunkard Sand			315	340	9		
B. Dunkard Sand			400	450			
1st. Salt Sand			675	760			
2nd. " "			775	830			
Maxon Sand			1175	1220			
Little Lime			1280	1310			
Big Lime			1325	1378			
Enjun Sand			1378	1496			
Gantz Sand			1790	1815			
50 Ft. Sand			1865	1940			
30 Ft. Sand			1960	1984			
Gordon Sand			2165	2180			
Fourth Sand			2218	2234			
Fifth Sand			2293	2319			
Total depth				2345'			



JUL 23 1959
(over)