

4.35S
2.63W

New Location
 Drill Deeper
 Abandonment 899

FORMERLY HOPE NATURAL GAS CO. WELL NO 899

Company A. M. SNIDER
 Address HUNDRED, W. VA
 Farm W. S. SWIGER
 Tract _____ Acres 64 Lease No. 2117
 Well (Farm) No. 1 Serial No. 899
 Elevation (Spirit Level) 1077
 Quadrangle CLARKSBURG, W. VA.
 County HARRISON District EAGLE
 Engineer HENRY A. HAIN
 Engineer's Registration No. 3150
 File No. A.M.S-3 Drawing No. _____
 Date APRIL 7, 1959 Scale 1" = 30 POLES

STATE OF WEST VIRGINIA
 DEPARTMENT OF MINES
 OIL AND GAS DIVISION
 CHARLESTON

WELL LOCATION MAP
 FILE NO. HAR-1627-A

+ Denotes location of well on United States Topographic Maps, scale 1 to 62,500, latitude and longitude lines being represented by border lines as shown.

- Denotes one inch spaces on border line of original tracing.



1591

STATE OF WEST VIRGINIA
DEPARTMENT OF MINES
OIL AND GAS DIVISION

WELL RECORD

Oil or Gas Well Gas

(KIND)

Quadrangle Clarksburg 1697A
 Permit No. Nov-1959 82
 Company A. M. Snider
 Address Hundred, W. Va.
 Farm W. S. Swiger Acres 64
 Location (waters) Ten Mile Creek
 Well No. 899 Elev. 1077
 District Eagle County Harrison
 The surface of tract is owned in fee by _____
 Address _____
 Mineral rights are owned by _____
 Address _____
 Drilling commenced 12/31/06
 Drilling completed 5/29/07
 Date Shot _____ From _____ To _____
 With _____
 Open Flow _____ /10ths Water in _____ Inch
 _____ /10ths Merc. in _____ Inch
 Volume _____ Cu. Ft.
 Rock Pressure _____ lbs. _____ hrs.
 Oil _____ bbls., 1st 24 hrs.
 WELL ACIDIZED _____

Casing and Tubing	Used in Drilling	Left in Well	Packers
Size			
16			Kind of Packer _____
13			<u>A.</u>
10	<u>455</u>		Size of <u>5 x 2</u>
8 1/4	<u>950</u>	<u>950</u>	
6 5/8	<u>1315</u>	<u>1315</u>	Depth set <u>2176</u>
5 3/16	<u>1950</u>	<u>1950</u>	
3	<u>62</u>	<u>62</u>	Perf. top _____
2	<u>2563</u>	<u>2563</u>	Perf. bottom _____
Liners Used			Perf. top _____
			Perf. bottom _____


CASING CEMENTED _____ SIZE _____ No. Ft. _____ Date _____

COAL WAS ENCOUNTERED AT _____ FEET _____ INCHES
 _____ FEET _____ INCHES FEET _____ INCHES
 _____ FEET _____ INCHES FEET _____ INCHES

WELL FRACTURED _____
 RESULT AFTER TREATMENT _____
 ROCK PRESSURE AFTER TREATMENT _____
 Fresh Water _____ Feet Salt Water _____ Feet

Formation	Color	Hard or Soft	Top	Bottom	Oil, Gas or Water	Depth	Remarks
Pitts. Coal			60' Below		Water	200	
B. Dunkard Sand			450	485			
Salt Sand			713	945	Water	840	
Injun Sand			1358	1478			
50' Sand			1860	1925			
Stray Sand			2030	2100			
Gordon Sand			2131	2152			
4th. Sand			2172	2215	Gas	2180	
5th. Sand			2342	2359	Gas	2344	
Total Depth				2453			

Handwritten notes: 2083' (2) and a circled symbol.

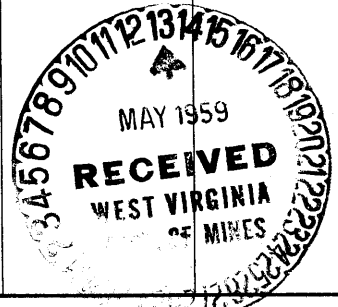

NOV 5 1959