

Surf: Oram Marsh, Rt.#2 Bristol, W.Va.  
 Coal: Mountaineer Coal Co., Box 1632, Fairmont, W.Va.

5.26S  
 1.94W

New Location   
 Drill Deeper   
 Abandonment

Map N39 STE4

Company SOUTH PENN OIL CO.  
 Address PARKERSBURG, W.VA.  
 Farm John T. Goodwin  
 Tract 154 3/4 of 300 Acres Lease No. 38483  
 Well (Farm) No. 8 Serial No. 32991  
 Elevation (Spirit Level) 1195.27 floor  
 Quadrangle CENTERPOINT  
 County HARRISON District TEN MILE  
 Engineer A.C. Hillcutt  
 Engineer's Registration No. 2534  
 File No. 1321 Drawing No. \_\_\_\_\_  
 Date APRIL 11, 1960 Scale 1" = 800'

STATE OF WEST VIRGINIA  
 DEPARTMENT OF MINES  
 OIL AND GAS DIVISION  
 CHARLESTON

**WELL LOCATION MAP**  
 FILE NO. HAR-1744-A

+ Denotes location of well on United States Topographic Maps, scale 1 to 62,500, latitude and longitude lines being represented by border lines as shown.

- Denotes one inch spaces on border line of original tracing.



1619

STATE OF WEST VIRGINIA  
DEPARTMENT OF MINES  
OIL AND GAS DIVISION

Quadrangle Centerpoint *EL*

Permit No. 1744A

WELL RECORD

Oil or Gas Well \_\_\_\_\_ (KIND)

Company SOUTH PINE OIL COMPANY  
Address P. O. Box 1280 Parkersburg, W. Va.  
John T. Goodwin *154 3/4 of*  
Farm \_\_\_\_\_ Acres 300  
Location (waters) Grass Run  
Well No. 8 Elev. 1195.27  
District Tom Mile County Harrison  
The surface of tract is owned in fee by Oran Marsh  
Rt. #2 Address Bristol, W. Va.  
Mineral rights are owned by Harward T. Goodwin, et al.  
N.F.D. #1 Address Salem, W. Va.

Casing and Tubing	Used in Drilling	Left in Well	Packers
Size			Kind of Packer
16			
13			
10	<u>292</u>	<u>None</u>	Size of
8 1/4	<u>1400</u>	<u>None</u>	
6 5/8	<u>2280</u>	<u>2280</u>	Depth set
5 3/16	<u>2951</u>	<u>2951</u>	
3			Perf. top
2			Perf. bottom
Liners Used			Perf. top
			Perf. bottom


Drilling commenced Sept. 4, 1919  
Drilling completed Nov. 15, 1919  
Date Shot 2 times From \_\_\_\_\_ To \_\_\_\_\_  
With \_\_\_\_\_  
Open Flow \_\_\_\_\_ /10ths Water in \_\_\_\_\_ Inch  
\_\_\_\_\_ /10ths Merc. in \_\_\_\_\_ Inch  
Volume \_\_\_\_\_ Cu. Ft.  
Rock Pressure \_\_\_\_\_ lbs. \_\_\_\_\_ hrs.  
Oil \_\_\_\_\_ bbls., 1st 24 hrs.  
WELL ACIDIZED \_\_\_\_\_  
WELL FRACTURED \_\_\_\_\_

CASING CEMENTED \_\_\_\_\_ SIZE \_\_\_\_\_ No. Ft. \_\_\_\_\_ Date \_\_\_\_\_

COAL WAS ENCOUNTERED AT 423 FEET 48 INCHES  
982 FEET 72 INCHES FEET INCHES  
FEET INCHES FEET INCHES

RESULT AFTER TREATMENT \_\_\_\_\_  
ROCK PRESSURE AFTER TREATMENT \_\_\_\_\_  
Fresh Water \_\_\_\_\_ Feet Salt Water \_\_\_\_\_ Feet

Formation	Color	Hard or Soft	Top	Bottom	Oil, Gas or Water	Depth	Remarks
Native Coal			<u>423</u>	<u>427</u>			
Pittsburgh Coal			<u>982</u>	<u>988</u>			
Little Dunkard			<u>1378</u>	<u>1425</u>			
Big Dunkard			<u>1436</u>	<u>1454</u>			
Gas Sand			<u>1567</u>	<u>1600</u>			
1st. Salt Sand			<u>1750</u>	<u>1816</u>			
2nd. Salt Sand			<u>1848</u>	<u>1896</u>			
3rd. Salt Sand			<u>2047</u>	<u>2125</u>			
Winton Sand			<u>2143</u>	<u>2160</u>			
Little Line			<u>2215</u>	<u>2230</u>			
Pencil Cave			<u>2230</u>	<u>2235</u>			
Big Line			<u>2235</u>	<u>2285</u>			
Big Injun			<u>2285</u>	<u>2380</u>			
Squaw Sand			<u>2475</u>	<u>2570</u>			
Guts Sand			<u>2725</u>	<u>2755</u>			
Fifty Foot Sand			<u>2830</u>	<u>2855</u>			
Thirty Foot Sand			<u>2926</u>	<u>2958</u>			
Stray Sand			<u>2984</u>	<u>3033</u>	Gas Show	<u>-2938</u>	
Gordon Sand			<u>3050</u>				
TOTAL DEPTH				<u>3067</u>			

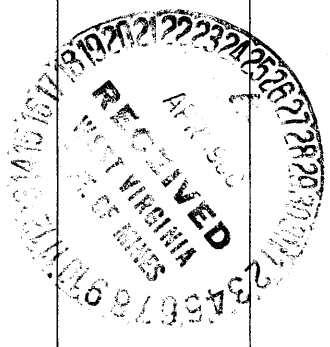

1st. Pay Oil 3053-3056  
2nd. Pay Oil 3061-3064

JAN 3 1961

Formation	Color	Hard or Soft	Top	Bottom	Oil, Gas or Water	Depth Found	Remarks

Date April 25, 1960

APPROVED SOUTH PINE OIL COMPANY, Owner

By George W. Wilman  
 George W. Wilman (Title) Land Agent