

New Location
 Drill Deeper
 Abandonment

Coal sold to Harry Beeson and Thomas Collier.
 Now owned by W. Guy Tetrick Hrs. Prunty Bldg.,
 Clarksburg, W. Va.
 Surface owned by the Lake Floyd Club, Inc.,
 Wolf Summit, West Va.

Company **RAAD SUPPLY CO.**
 Address **Salem, W. Va.**
 Farm **J. B. Conway**
 Tract _____ Acres **175.73** Lease No. _____
 Well (Farm) No. **One & Two** Serial No. **118** *from year 1961*
 Elevation (Spirit Level) ~~1181~~ - **1287** ~~1405~~
 Quadrangle **Centerpoint**
 County **Harrison** District **Tennile**
 Engineer **W. H. Hall Jr.**
 Engineer's Registration No. **1227**
 File No. _____ Drawing No. _____
 Date **August, 1960** Scale **1" = 40 poles.**

STATE OF WEST VIRGINIA
 DEPARTMENT OF MINES
 OIL AND GAS DIVISION
 CHARLESTON

WELL LOCATION MAP
 FILE NO. **HAR-1761-A #2**
HAR-1762-A #1

+ Denotes location of well on United States Topographic Maps, scale 1 to 62,500, latitude and longitude lines being represented by border lines as shown.

- Denotes one inch spaces on border line of original tracing.



1624

STATE OF WEST VIRGINIA
DEPARTMENT OF MINES
OIL AND GAS DIVISION

Entrypoint SR
176-A

WELL RECORD

Permit No. _____ Oil or Gas Well _____ (KIND)

Company Rad Supply Company
Address 184 East Main St., Salem, W. Va.
Farm J. B. Conaway Acres 175.734
Location (waters) _____
Well No. 1 Elev. 1405
District Ten Mile County Harrison
The surface of tract is owned in fee by Lake Floyd Club
Wolf Summit Address W. Va.
Mineral rights are owned by W. Guy Tidrick, Hrs.
Prunty Bldg. Address Clarksburg, W. Va.


Casing and Tubing	Used in Drilling	Left in Well	Packers
Size			Kind of Packer
16			
13			
10			Size of
8 1/4			
6 3/8	2900'	2900'	Depth set
5 3/16			
3			Perf. top
2	2120'	2120'	Perf. bottom
Liners Used			Perf. top
			Perf. bottom

Drilling commenced _____
Drilling completed _____
Date Shot _____ From _____ To _____
With _____
Open Flow _____ /10ths Water in _____ Inch
_____ /10ths Merc. in _____ Inch
Volume _____ Cu. Ft.
Rock Pressure _____ lbs. _____ hrs.
Oil _____ bbls., 1st 24 hrs.
Fresh water _____ feet _____ feet
Salt water _____ feet _____ feet

CASING CEMENTED _____ SIZE _____ No. Ft. _____ Date _____

COAL WAS ENCOUNTERED AT **777** FEET **40** INCHES
_____ FEET _____ INCHES _____ FEET _____ INCHES
_____ FEET _____ INCHES _____ FEET _____ INCHES

Formation	Color	Hard or Soft	Top	Bottom	Oil, Gas or Water	Depth Found	Remarks
Pittsburgh Coal			777	781			
Big Dunkard Sand			1285	1385			
Big Lime			2108	2163			
Big Injun Sand			2163	2253			
Thirty Foot Sand			2752	2767			
Gorden Stray Sand			2836	2856			
Gorden Sand			2863	2885			
Total Depth			2900				

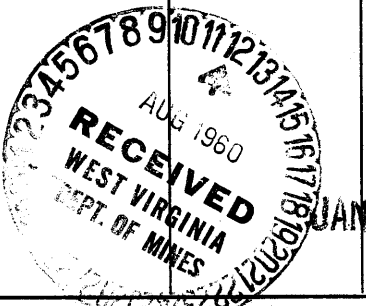

3 1961