

New Location
 Drill Deeper
 Abandonment

JUN 7 1961

MAP SHEET 41, 5-6 E-16, F.B. 530 P.14

Company HOPE NATURAL GAS CO.
 Address CLARKSBURG, WVA.
 Farm FAIRMONT COAL CO.
 Tract _____ Acres 1083.6 Lease No. 43717
 Well (Farm) No. _____ Serial No. 6995
 Elevation (Spirit Level) 1016'
 Quadrangle CLARKSBURG
 County HARRISON District EAGLE
 Engineer Guy H. Bradley
 Engineer's Registration No. 2425
 File No. _____ Drawing No. _____
 Date 10/31/60 Scale 1" = 800'

STATE OF WEST VIRGINIA
 DEPARTMENT OF MINES
 OIL AND GAS DIVISION
 CHARLESTON

WELL LOCATION MAP
 FILE NO. HAR-1776-A

+ Denotes location of well on United States Topographic Maps, scale 1 to 62,500, latitude and longitude lines being represented by border lines as shown.

- Denotes one inch spaces on border line of original tracing.



1044

STATE OF WEST VIRGINIA
DEPARTMENT OF MINES
OIL AND GAS DIVISION

Quadrangle Clarksburg

Permit No. 1776-A

WELL RECORD

Oil or Gas Well Gas
(KIND)


Company Hope Natural Gas Company
Address Clarksburg, W. Va.
Farm Fairmont Coal Co. Acres 1083
Location (waters) _____
Well No. 6995 Elev. 1016
District Eagle County Harrison
The surface of tract is owned in fee by _____
Address _____
Mineral rights are owned by _____
Address _____
Drilling commenced 9-8-14
Drilling completed 9-30-14
Date Shot Not From _____ To _____
With _____
Open Flow _____/10ths Water in _____ Inch
_____/10ths Merc. in _____ Inch
Volume Dry (Exhausted) Cu. Ft.
Rock Pressure _____ lbs. hrs.
Oil None bbls., 1st 24 hrs.
WELL ACIDIZED No
WELL FRACTURED No

Casing and Tubing	Used in Drilling	Left in Well	Packers
Size			Kind of Packer
16			
13			
10	202	202	Size of
8 3/4	1102	1102	
6 5/8			Depth set
5 3/16			
3	1517	1517	Perf. top
2			Perf. bottom
Liners Used			Perf. top
			Perf. bottom

CASING CEMENTED _____ SIZE _____ No. Ft. _____ Date _____
10" casing cemented 190'
COAL WAS ENCOUNTERED AT 70 FEET 72 INCHES
____ FEET _____ INCHES _____ FEET _____ INCHES
____ FEET _____ INCHES _____ FEET _____ INCHES

RESULT AFTER TREATMENT _____
ROCK PRESSURE AFTER TREATMENT _____
Fresh Water No record Feet _____ Salt Water _____ Feet _____

Formation	Color	Hard or Soft	Top	Bottom	Oil, Gas or Water	Depth	Remarks
Pittsburgh Coal			70	76			
Little Dunkard			404	458			
Big Dunkard			510	525			
Gas Sand			605	620			
1st Salt			755	832			
2nd Salt Sand			840	905			
3rd Salt Sand			910	1010			
Sand			1016	1024			
Little Lime			1385	1408			
Big Lime			1418	1478			
Big Injan			1478	- -	Gas	1481	
Total Depth				1510'			

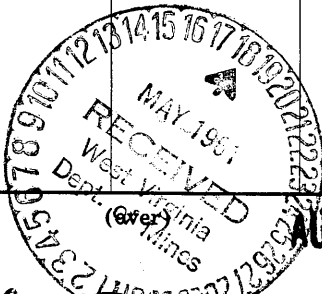

May 17, 1961
Jack Bailey
H. N. G. Co.

FAIRMONT COAL Co No 6995 - HOPE NG Co - HAR-1776-A