

New Location
 Drill Deeper
 Abandonment

JUL 16 1961

Map Sheet 56 Squares S17E13 F.B. 529P.13

Company HOPE NATURAL GAS CO.
 Address CLARKSBURG, W. VA.
 Farm M. J. SIDEBOTTOM
 Tract _____ Acres 38 Lease No. 28651
 Well (Farm) No. _____ Serial No. 5835
 Elevation (Spirit Level) _____ 1271
 Quadrangle WESTON
 County HARRISON District UNION
 Engineer Guy H. Bradley
 Engineer's Registration No. 2425
 File No. _____ Drawing No. _____
 Date 10-26-60 Scale 1" = 40 POLES

STATE OF WEST VIRGINIA
 DEPARTMENT OF MINES
 OIL AND GAS DIVISION
 CHARLESTON

WELL LOCATION MAP
 FILE NO. HAR-1779-A

+ Denotes location of well on United States Topographic Maps, scale 1 to 62,500, latitude and longitude lines being represented by border lines as shown.

- Denotes one inch spaces on border line of original tracing.



1666

STATE OF WEST VIRGINIA
DEPARTMENT OF MINES
OIL AND GAS DIVISION

Quadrangle Weston
Permit No. 1779A

WELL RECORD

Oil or Gas Well Gas
(KIND)


Company Hope Natural Gas Company
Address Clarksburg, W. Va.
Farm H.J. Sidebottom Acres 38
Location (waters) _____
Well No. 5835 Elev. 1271
District Union County Harrison
The surface of tract is owned in fee by _____
Address _____
Mineral rights are owned by _____
Address _____
Drilling commenced 11-9-20
Drilling completed 2-14-21
Date Shot 2-16-21 From 3268 To 3278
With 20 Qts. Nitro
Open Flow /10ths Water in _____ Inch
/10ths Merc. in _____ Inch
Volume Exhausted (Old Well) Cu. Ft.
Rock Pressure None lbs. _____ hrs.
Oil None bbls., 1st 24 hrs.
WELL ACIDIZED No
WELL FRACTURED No

Casing and Tubing	Used in Drilling	Left in Well	Packers
Size			Kind of Packer
16			
13			
10	207	207	Size of
8 3/4	1152	1152 Filled	Depth set
6 3/4	1676	1676	
5 3/16	2488	2488	
3	54	54	Perf. top
2	3281	3281	Perf. bottom
Liners Used			Perf. top
			Perf. bottom

CASING CEMENTED _____ SIZE _____ No. Ft. _____ Date _____
167' of 10" is cemented
COAL WAS ENCOUNTERED AT 112 FEET 48 INCHES
140 FEET 8 1/2 INCHES FEET INCHES
FEET INCHES FEET INCHES

RESULT AFTER TREATMENT _____
ROCK PRESSURE AFTER TREATMENT _____
Fresh Water None Feet _____ Salt Water 1115 Feet _____

Formation	Color	Hard or Soft	Top	Bottom	Oil, Gas or Water	Depth	Remarks
Coal			112	116			
Pittsburgh Coal			140	147			
Big Dunkard			640	700			
Gas Sand			775	805			
First Salt			807	1032			
2nd Salt			1040	1080			
3rd Salt			1110	1135	Water	1115 1115	Fresh
Little Lane			1570	1590			
Pencil Cave			1590	1600			
Big Lane			1600	1660			
Big Injun			1660	1783			
Garts			2084	2129			
Fifty Foot			2138	2214			
30' sand			2230	2268			
Gordon Stray			2365	2438			
Gordon			2442-	2472	Gas	2444 2444 2455'	
Fourth			2502	2522			
Fifth			2575	2595	Gas	2580	
Speckley			3268	3278	Gas	3273'	
Total Depth				3308'			

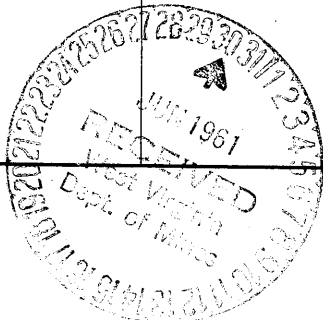

APR 6 1962

November 1, 1960
Jack B. Bailey
H. N. G. Co.

(over)